


DATE _____

TOWN OF LEXINGTON — BOARD OF PUBLIC WORKS

SEWER DIVISION

Sketch of Service Here **29**

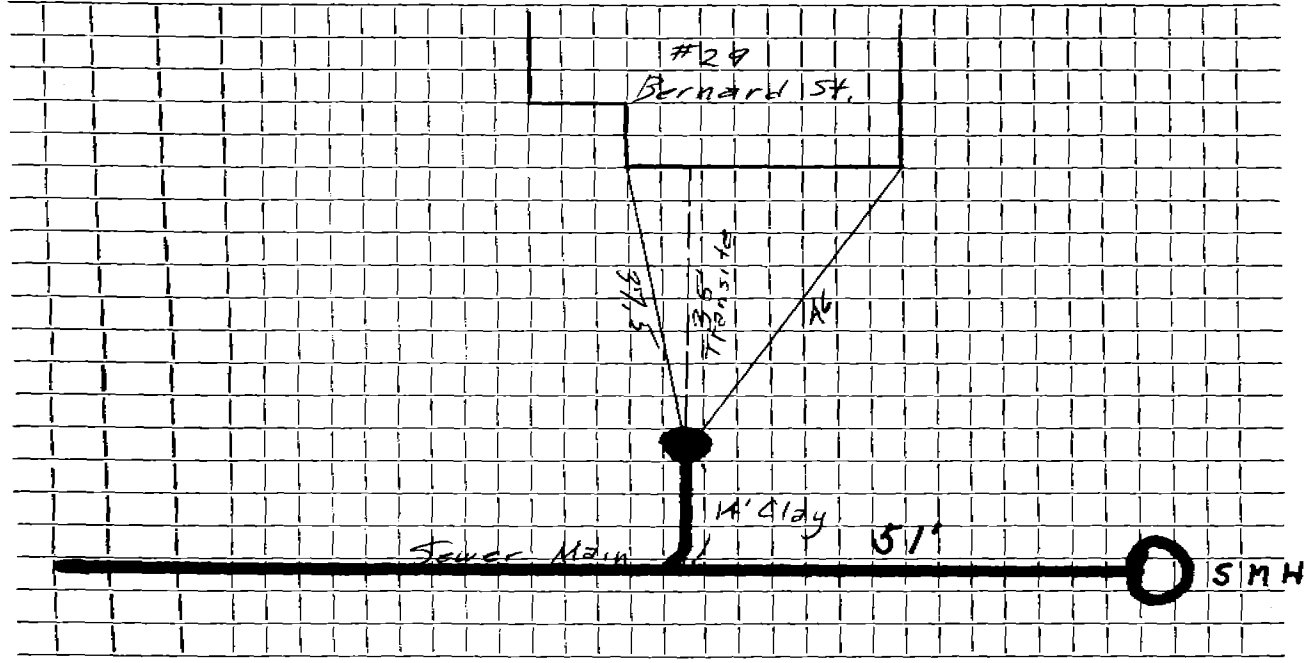

Connection made in Street. Work completed

Remarks: Sewer renewed to same st. connection - Original service 10-7-53