

Name John Anderson

Service No. 173

Address 30 Bernard St.

Lexington

Location

Kind of Pipe

Size

Size of Main

~~Repair~~ ~~Renewal~~ — New Service

COM.11-23-53

Location

Date	Material	Amount	Total	Date	Amount
10/7/53	Labor	15 00		10-1-53	Deposited 125 -
10/8/53	Labor	28 80		11-23-53	Refunded (28) 22
		43 80			96 28
	10% overhead	4 38	48 18		
	56'-6" Sewer Pipe @.3036		17 00		
	1-6" 1/8 Bend		1 24		
	Joint Compound		3 36		
	5 Hr. Town Shovel @5.00		25 00		
	2 Hr. Trucking		1 50		
			96 28		
	<b>Labor</b>				

**TOWN OF LEXINGTON—DEPT. OF PUBLIC WORKS**  
**SEWER DIVISION**

DATE .....

NO. ....

The undersigned applies for the construction of a particular sewer connecting No. ....  
Street and hereby agrees to comply with the Rules and Regulations governing the construction and use of Particular  
Sewers, as now or at any future time established by the Board of Selectmen.

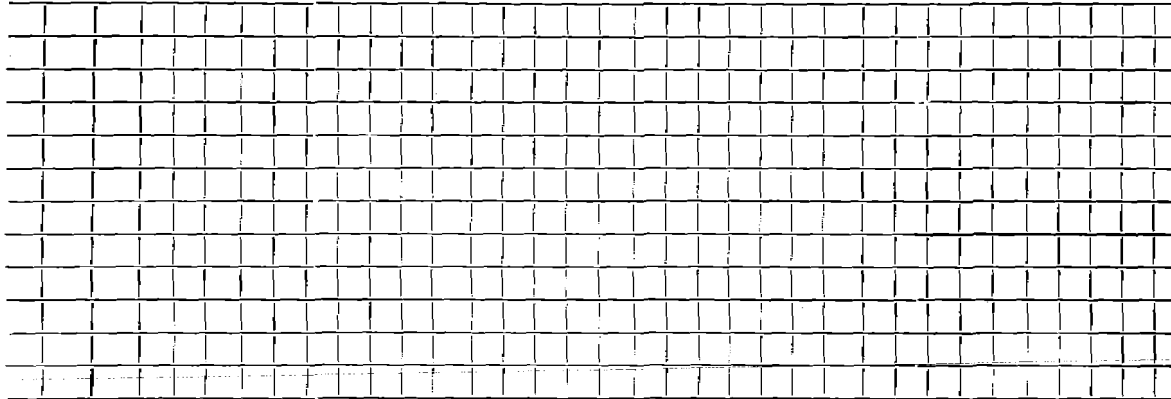
Am't of estimate \$. ....

Am't Paid \$. ....

..... Owner

---

**Sketch of Service Here**

A large grid for sketching the sewer service area. The grid consists of 15 columns and 18 rows of small squares. The grid is empty, intended for the applicant to draw a sketch of the sewer service here.

Connection made in ..... Street.

Work completed ..... 19..

Remarks: