

Name Burton C. Mitchell

Service No. 157

Address 34 Bernard Street

Location

Kind of Pipe

Size

Size of Main

~~Repair/ Renewal~~ New Service

COM.10-5-53

Location

Date		Material	Amount	Total	Date	Amount
9/10/53	Labor		66 60		9-1-53	125 -
	10% overhead		6 66	73 26	10-5-53	(14) 45
	52' -6" sewer pipe @ .3036			15 79		110 55
	1 - 6" elbow			1 88		
	joint compound			3 12		
	3 hrs. town shovel @ 5.00			15 00		
	2 hrs. trucking @ .75			1 50		
				110 55		
	Labor					

**TOWN OF LEXINGTON—DEPT. OF PUBLIC WORKS
SEWER DIVISION**

DATE

NO.


The undersigned applies for the construction of a particular sewer connecting No.
Street and hereby agrees to comply with the Rules and Regulations governing the construction and use of Particular
Sewers, as now or at any future time established by the Board of Selectmen.

Am't of estimate \$

Am't Paid \$

..... Owner

Sketch of Service Here

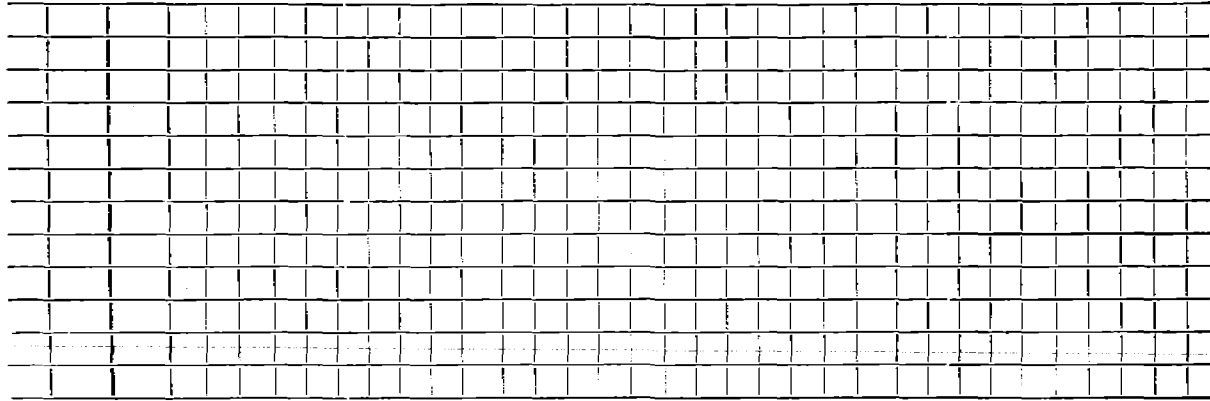

Connection made in Street.

Work completed 19..

Remarks: