

Name Eric G. Sahlberg

Service No. 179 (1956)

Address 37 Bernard Street

Location

Comm. 3/18/57

Kind of Pipe

Size

Size of Main

~~Repair or Renewal~~ New Service

Location

Date	Material	Amount	Total	Date		Amount
12-3-56	Labor	38.38		11-28-56	Deposit	# 200.00
	10% O.H.	3.84	42.22	3-18-57	Refund	131.53
	50' 6" Sewer pipe @.435		21.75			# 68.47
	Joint Compound		3.00			
	2 hr1 Trucking @.75		1.50			
			68.47			
	INSTALLED BY CONTRACTOR					
	30' - 6" V.C. Pipe @ \$3.00		90.00			
	Labor					

TOWN OF LEXINGTON—DEPT. OF PUBLIC WORKS

SEWER DIVISION

DATE

NO.


The undersigned applies for the construction of a particular sewer connecting No. Street and hereby agrees to comply with the Rules and Regulations governing the construction and use of Particular Sewers, as now or at any future time established by the Board of Selectmen.

Am't of estimate \$.....

Am't Paid \$.....

..... Owner

Sketch of Service Here **37**

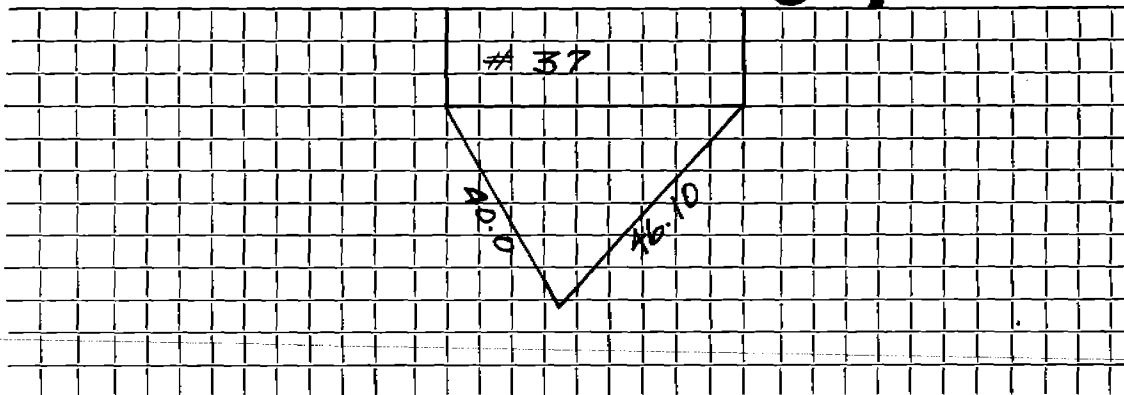

Connection made in Street.

Work completed 19..

Remarks: