

Name Eric Sahlberg

Service No. 52

Address 39 Bernard Street

Location

Comm. 7/22/57

Kind of Pipe

Size

Size of Main

Repair - Renewal - New Service

Location

Date	Material	Amount	Total	Date	Amount	
4/26/57	Labor	27 37		4-24-57	Deposit	\$ 150 00
	10% overhead	2 74	30 11	7-22-57	Refund	75 62
	36' - 6" Transite Pipe @ .7020		25 27			74 38
	2 hrs. Town Shovel @ 6.50		13 00			
	1 hr. Trucking		3 00			
	1 hrs. Rodgers Trailer		3 00			
			74 38			
	INSTALLED BY CONTRACTOR					
	28' - 6" V.C. Pipe @ \$3.00		84.00			
	Labor					
	Service installed to curb by contractor - not previously charged.					

TOWN OF LEXINGTON—DEPT. OF PUBLIC WORKS

SEWER DIVISION

DATE .....

NO. ....


The undersigned applies for the construction of a particular sewer connecting No. ....  
Street and hereby agrees to comply with the Rules and Regulations governing the construction and use of Particular  
Sewers, as now or at any future time established by the Board of Selectmen.

Am't of estimate \$.....

Am't Paid \$.....

..... Owner

Sketch of Service Here **39** SS. For #39

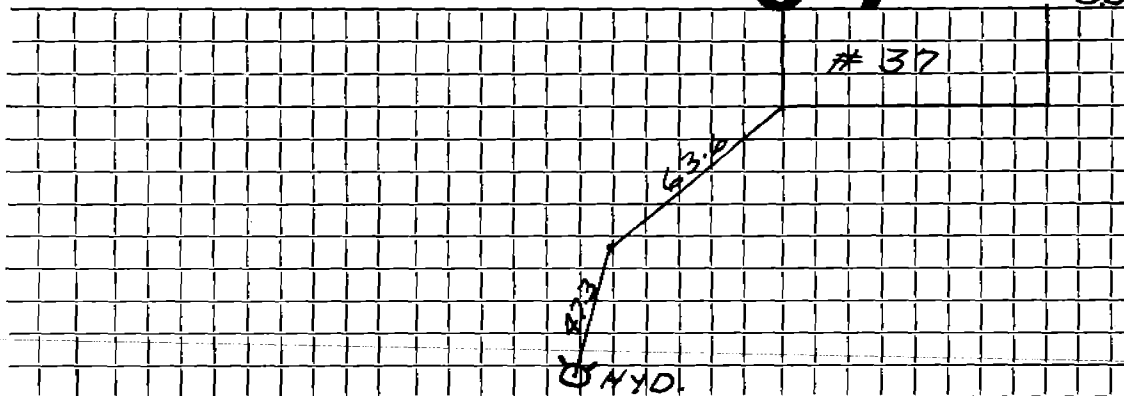

Connection made in ..... Street.

Work completed ..... 19..

Remarks: