

Name William H. Sullivan

Service No. 155

Address 40 Bernard St.

Location

Kind of Pipe

Size

Size of Main

~~Repair Renewal~~ New Service

COM. 10-5-53

Location

Date	Material	Amount	Total	Date	Amount
9/9/53	Labor	70 50		8-26-53	Deposited 125 00
	10% overhead	7 05	77 55	10-5-53	Refunded 10 86
	52' - 6" sewer pipe @ .3036		15 79		114 20
	1 - 6" 1/8 bend		1 24		
	joint compound		3 12		
	3 hrs. town shovel @ 5.00		15 00		
	2 hrs. trucking		1 50		
			114 20		
	Labor				

TOWN OF LEXINGTON—DEPT. OF PUBLIC WORKS SEWER DIVISION

DATE

NO.


The undersigned applies for the construction of a particular sewer connecting No.
Street and hereby agrees to comply with the Rules and Regulations governing the construction and use of Particular
Sewers, as now or at any future time established by the Board of Selectmen.

Am't of estimate \$.....

Am't Paid \$.....

..... Owner

Sketch of Service Here

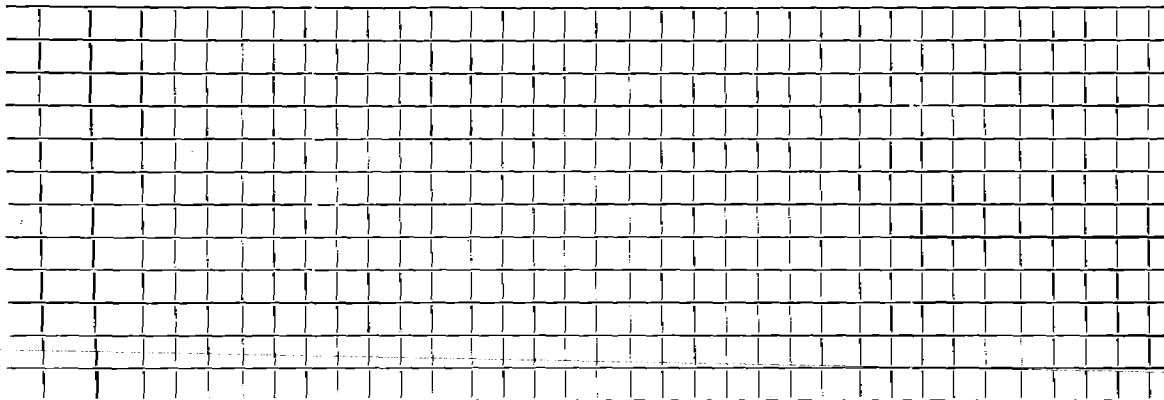

Connection made in Street. Work completed 19..

Remarks: