

Name

Service No.

Address ^F 43 Berwick St

Location 209 # 196

Kind of Pipe

Size

Size of Main

Repair—Renewal—New Service

Location

Date	Material	Amount	Total	Date	Amount
	32' 6" V.C. Sewer Pipe				
	Installed by Cont. @ 3.00 per ft.		96.00		
	Billed when connected				
	Labor				

TOWN OF LEXINGTON—DEPT. OF PUBLIC WORKS
SEWER DIVISION

DATE.....

NO.

The undersigned applies for the construction of a particular sewer connecting No.....
Street and hereby agrees to comply with the Rules and Regulations governing the construction and use of Particular
Sewers, as now or at any future time established by the Board of Selectmen.


Am't of estimate \$.....

Am't Paid \$.....

..... Owner

Sketch of Service Here **43**

S.S. For # 43

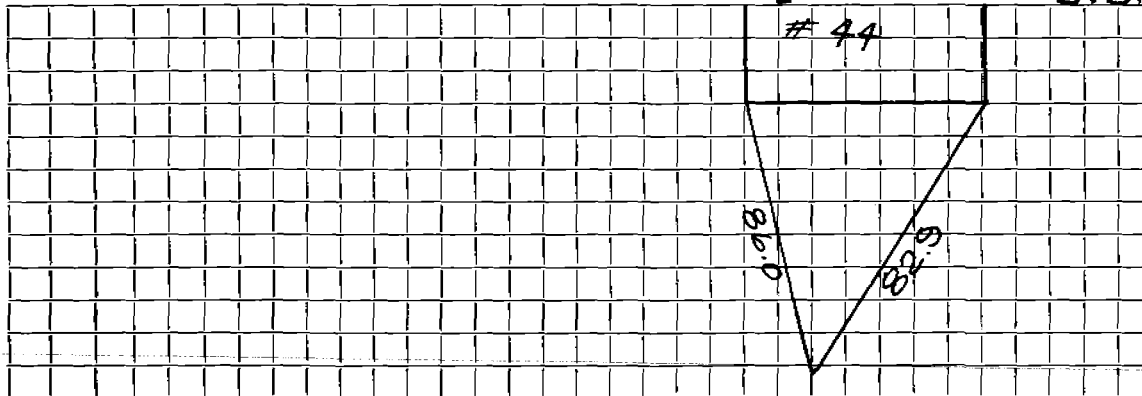

Connection made in Street.

Work completed.....19..

Remarks: