

Name **Verett Twombly**

Service No. **1114**

Address **104 Bertwell Road**

Location **104 Bertwell Road**

Kind of Pipe

Size

Size of Main

~~Repair Sewer~~ **New Service**

Location

Date	Material	Amount	Total	Date	Amount
Nov. 6, 47	Labor	50 26		Nov. 5 '47	125 00
7	"	29 90	80 16	Dec. 31 47	18 42
	10% Overhead		8 02		106 58
	53' - 6" Sewer Pipe @.26		13 78		
	Joint Compound		3 12		
	Trucking 2 hrs. @.75		1 50		
			106 58		
	Labor				
	<i>Com 12/31/47</i>				

TOWN OF LEXINGTON—DEPT. OF PUBLIC WORKS

SEWER DIVISION

DATE

NO.

The undersigned applies for the construction of a particular sewer connecting No.
Street and hereby agrees to comply with the Rules and Regulations governing the construction and use of Particular
Sewers, as now or at any future time established by the Board of Selectmen.


Am't of estimate \$.....

Am't Paid \$.....

..... Owner

Sketch of Service Here

104

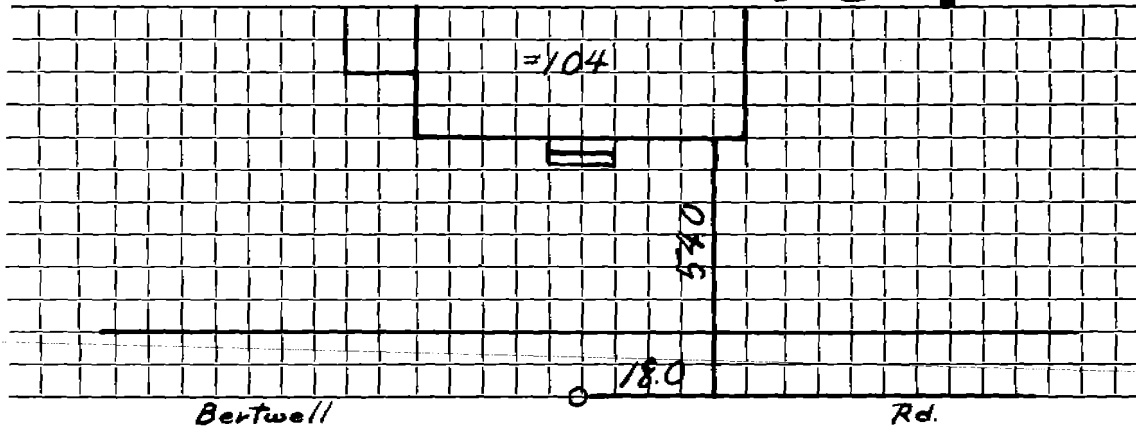

Connection made in Street.

Work completed 19..

Remarks: