

Name Samuel Gazun

Service No. ⁶⁷ 1116

Address 108 Bertwell Road

Location 108 Bertwell Road

Kind of Pipe

Size

Size of Main

~~Repair - Renewal~~ - New Service

Location

Date	Material	Amount	Total	Date	Amount
Nov. 7, '47	Labor	37 50		Nov 6 '47	125 00
8	"	7 90	45 40	Dec. 31 47	28 28
	10% Overhead		4 54		96 72
	54' - 6" Sewer Pipe @.26		14 04		
	Joint Compound		3 24		
	Hired Shovel 4 hrs. @ 7.00		28 00		
	Trucking 2 hrs. @.75		1 50		
			96 72		
	Labor				
	<i>Contracting</i>				

TOWN OF LEXINGTON—DEPT. OF PUBLIC WORKS
SEWER DIVISION

DATE

NO.

The undersigned applies for the construction of a particular sewer connecting No.
Street and hereby agrees to comply with the Rules and Regulations governing the construction and use of Particular
Sewers, as now or at any future time established by the Board of Selectmen.


Am't of estimate \$.

Am't Paid \$.

..... Owner

Sketch of Service Here

108

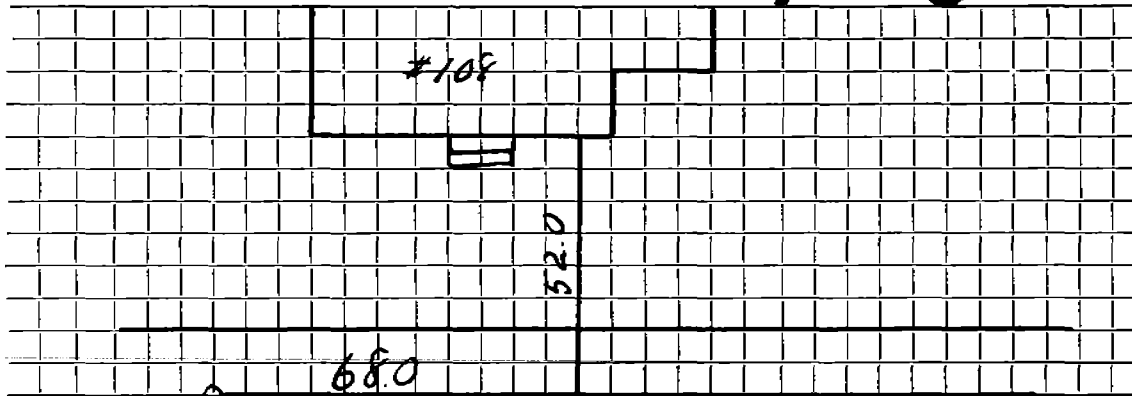

Bertwell

Rd.

Connection made in Street.

Work completed 19..

Remarks: