
Name					Service No.			
Ad	dress	14 BERT	MELL					
	Location							
Ki	Kind of Pipe					Size of Main		
Re	pair—R	Renewal—New Service				Location		
Date		Material	Amount	Total	Date	Amount		
-5	02							
	 	4" PVC 8	3' 6"				·	
	1	6" PVC 39						
<u> </u>		6 100		 				
		1 6x6 CL,	AY TUPUC					
	_							
		14X6	-					
		2 22° BE	1/15	 				
			7400					
 -		· ·	 					
				#				
· ·	1 -	\$						

DATE 4-5-02

TOWN OF LEXINGTON - BOARD OF PUBLIC WORKS

SEWER DIVISION

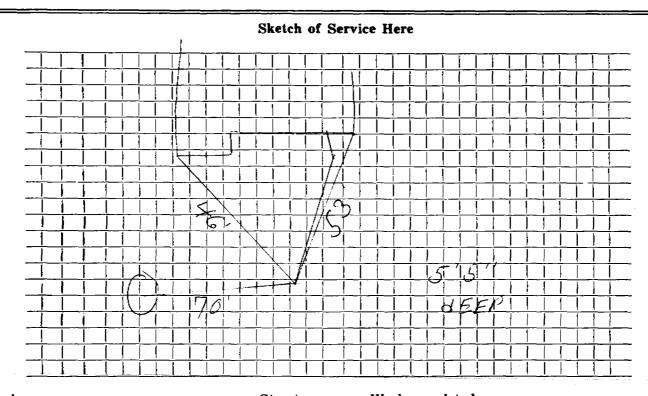

Connection made in Street.	Work completed
Remarks:	