

Name Albert Wilson

Service No. 88 1115

Address

Location 82 Bertwell Road

Kind of Pipe

Size

Size of Main

~~Repair~~ ~~Renewal~~ New Service

Location

Date	Material	Amount	Total	Date	Amount
11/11/47	Labor	23 02		11/6/47	175 00
11/15/47	"	61 13		12/31/47	13 75
11/17/47	"	3 95	88 10		161 25
	10% Overhead	8 81	8 81		
	62'6" S ewer Pipe		16 12		
	Joint Compound		3 72		
	4 hrs. Hired Shovel @ 7.00		28 00		
	2 hrs. Trucking		1 50		
	Patching 15x3		15 00		
			161 25		
	<b>Labor</b>				
	<i>Jan 12/47</i>				

TOWN OF LEXINGTON—DEPT. OF PUBLIC WORKS

SEWER DIVISION

DATE .....

NO. ....


The undersigned applies for the construction of a particular sewer connecting No. ....  
Street and hereby agrees to comply with the Rules and Regulations governing the construction and use of Particular  
Sewers, as now or at any future time established by the Board of Selectmen.

Am't of estimate \$.....

Am't Paid \$.....

..... Owner

Sketch of Service Here **32**

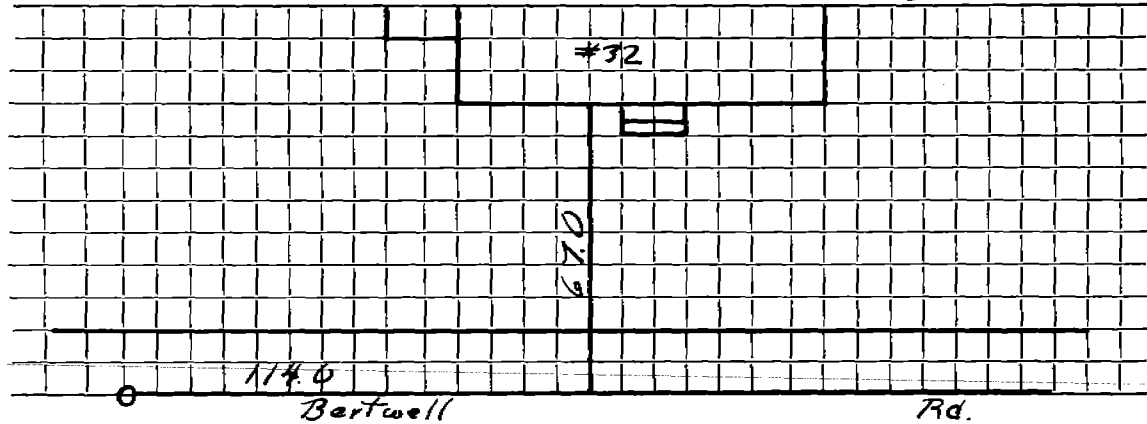

Connection made in ..... Street.

Work completed ..... 19..

Remarks: