


DATE _____

TOWN OF LEXINGTON — BOARD OF PUBLIC WORKS
SEWER DIVISION

Sketch of Service Here

43

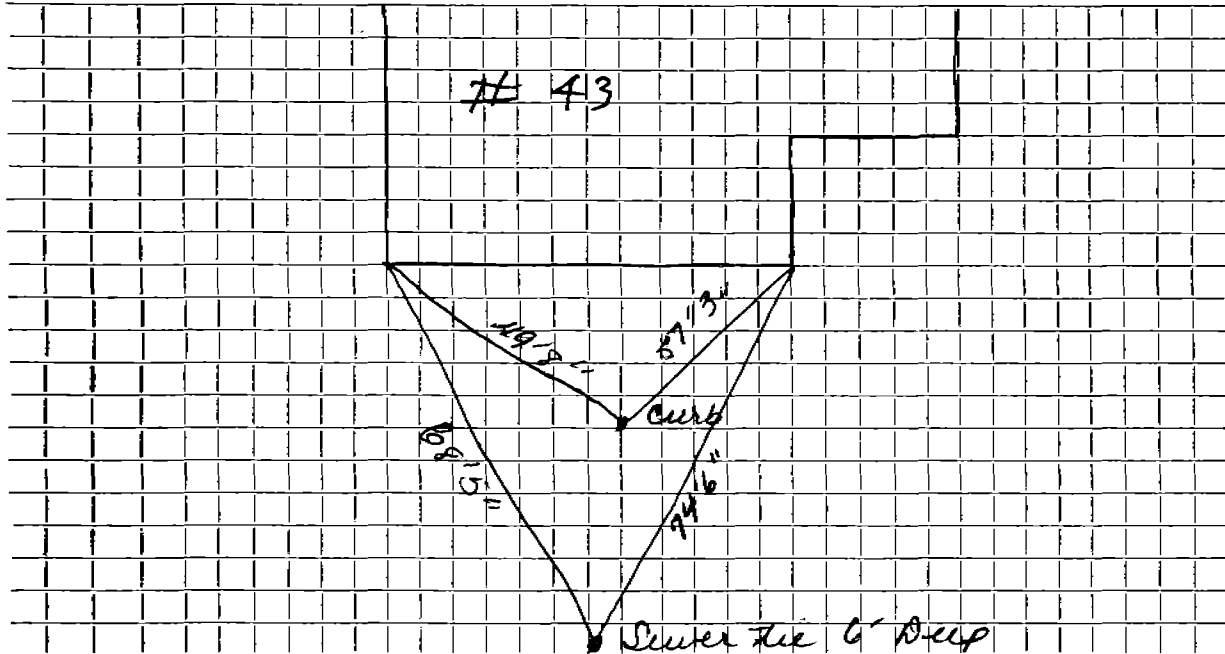

Connection made in Street. Work completed

Remarks: Original Service 1-2-53