

Name Gordan Chase

Service No. 52 1101

Address

Location 60 Bertwell

Kind of Pipe

Size

Size of Main

~~Repair~~ New Service

Location

Date	Material	Amount	Total	Date	Amount
11/17/47	Labor	13 28		10/23/47	135 00
11/19/47	"	11 70		12/31/47	47 34
11/20/47		12 60	37 58		87 66
	10% Overhead		3 76		
	52' 6" Sewer Pipe @ .26		13 52		
	1 6" Elbow		1 18		
	Joint Compound		3 12		
	3 hrs. Hired Shovel @ 7.00		21 00		
	2 hrs. Loader @ 3.00		6 00		
	2 hrs. Trucking		1 50		
			87 66		
	<b>Labor</b>				
	<i>Completed by</i>				

TOWN OF LEXINGTON—DEPT. OF PUBLIC WORKS

SEWER DIVISION

DATE .....

NO. ....

The undersigned applies for the construction of a particular sewer connecting No. .... Street and hereby agrees to comply with the Rules and Regulations governing the construction and use of Particular Sewers, as now or at any future time established by the Board of Selectmen.


Am't of estimate \$.....

Am't Paid \$.....

*1000 1/2 ft*  
*2 1/2 ft*

..... Owner

Sketch of Service Here

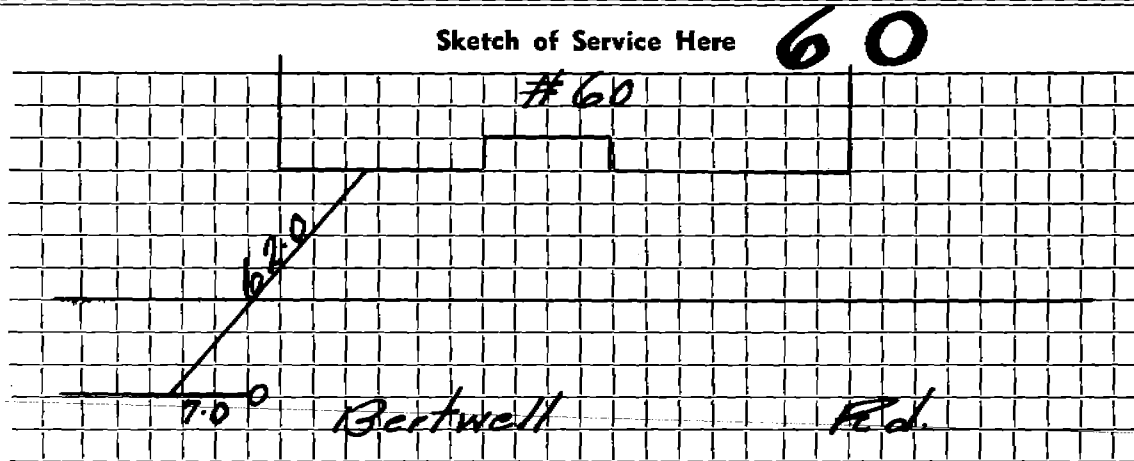

Connection made in ..... Street.

Work completed ..... 19..

Remarks: