

Name

Service No.

Address

68 Beafwell

Location

Kind of Pipe

Size

Size of Main

Repair—Renewal—New Service

Location

Date

Material

Amount

Total

Date

Amount

6-8-01

Inside Renewed

6x6x6 wye clean out
6x6 clay to PVC franco
33' - 6" PVC


7-13-01

Respond To Call SmJR

DATE _____

TOWN OF LEXINGTON — BOARD OF PUBLIC WORKS
SEWER DIVISION

Sketch of Service Here

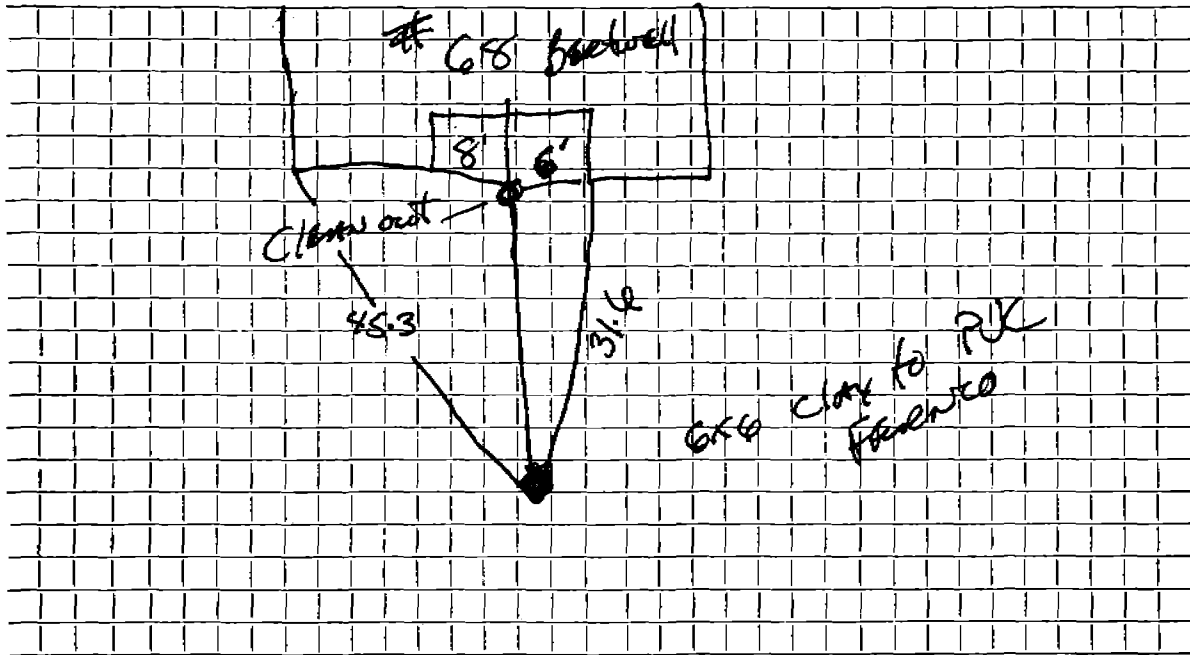

Connection made in Street. Work completed

Remarks:

.....

.....

Name William P. Rice

Service No. 147

Address 68 Bartwell Road

Location

Kind of Pipe

Size

Size of Main

~~Repair~~ New Service

COM.10-5-53

Location

Date	Material	Amount	Total	Date	Amount
9/9/53	Labor	81 92		8-13-53	Deposited 175 00
	10% overhead	8 19	90 11	10-5-53	Refunded (398
	50' - 6" sewer pipe @ .3036		15 18		171 02
	joint compound		3 00		
	14 lbs. dynamite @ .24		3 36		
	13 exploders @ .1435		1 87		
	2 hrs. #37 compressor @ 1.75		3 50		
	7 hrs. Littlefield shovel @ 7.50		52 50		
	2 hrs. trucking		1 50		
			171 02		
	Labor			6/13/66	JOINTS

