

Name John Larrabee

Service No. 152

Address 78 Bertwell Road

Location

Kind of Pipe

Size

Size of Main

~~Renewal~~—Renewal—~~New Service~~ W.O. #8264

Location MAR 23 1964

Date	Material	Amount	Total	Date	Amount
11-6-63	Labor	113.79		4-25-63	100.00
	10% O.H.	11.38	125.17	4-17-64	5.56
	40' 6" Transite pipe @.82		32.80		105.56
	2 hrs. Town Shovel @6.50		13.00	6-2-54	
	14 x 3 Patch		14.00	20' 6" Sewer Pipe	
	4 yards. Loam @3.00		12.00		
	2 hrs. Trucking @3.00		6.00		
			202.97		
	PRO RATE				
	$\frac{202.97}{25} = 8.12 \times 13 = 105.56$				
				1-22-70	slugs
				4-11-66	Roots
				4-27-73	Roots 12-4-77 Solids
				9-5-73	Letter Sent 12-5-73 Roots


DATE _____

TOWN OF LEXINGTON — BOARD OF PUBLIC WORKS

SEWER DIVISION

Sketch of Service Here

78

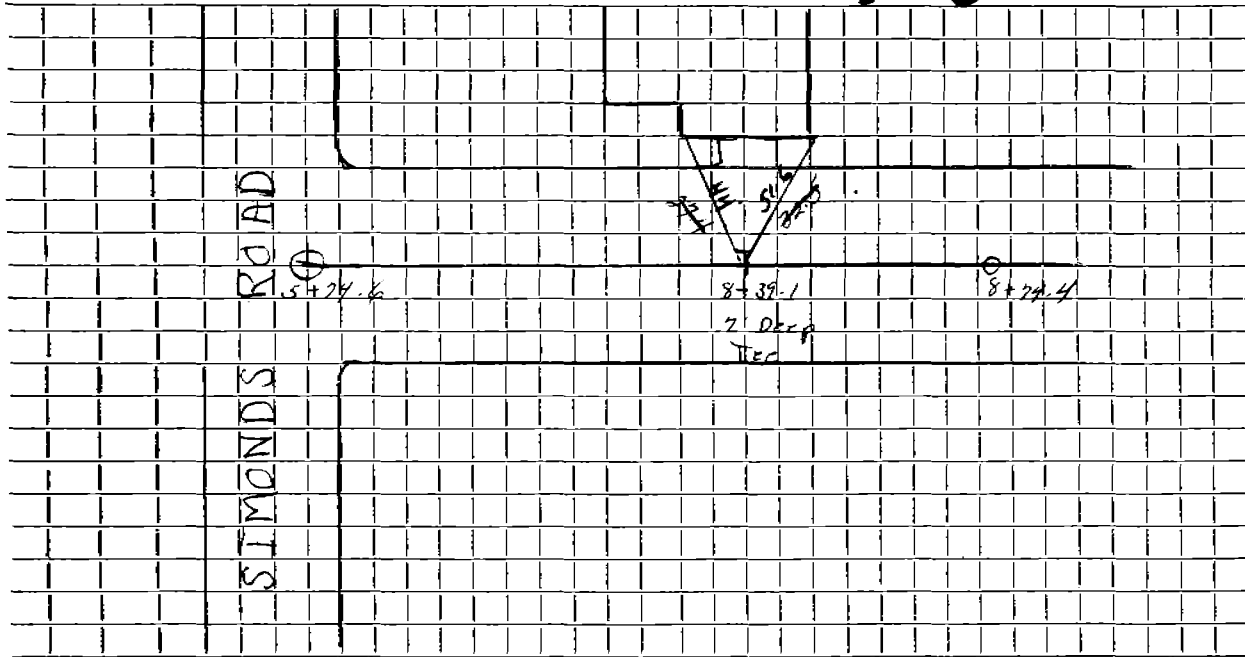

Connection made in Street. Work completed

Remarks: *Original Service 10-5-50*