

Name Nicholas DeBonis

Service No. 194

Address 79 Bertwell Road

Location

Kind of Pipe

Size

Size of Main

~~Service Renewal~~—New Service W.O.O. #7728


Location *Wm 1-17-63*

Date	Material	Amount	Total	Date		Amount
11-15-62	Labor 40.18			11-13-62	Deposit	250.00
11-16-62	" 38.47	78.65		1-14-63	ReFund	44.17
	10% O.H.	7.87	86.52			205.83
	55' 6" Transite Pipe @.82		45.10			
	1 90° Transite Elbow		4.09			
	1 6" Duplex Adapter		1.62			
	7 hrs. Town Shovel @6.50		45.50			
	3 hrs. Trucking @3.00		9.00			
	14 x 3 Patch		14.00			
			205.83			

DATE \_\_\_\_\_

TOWN OF LEXINGTON — BOARD OF PUBLIC WORKS  
SEWER DIVISION

Sketch of Service Here **79**

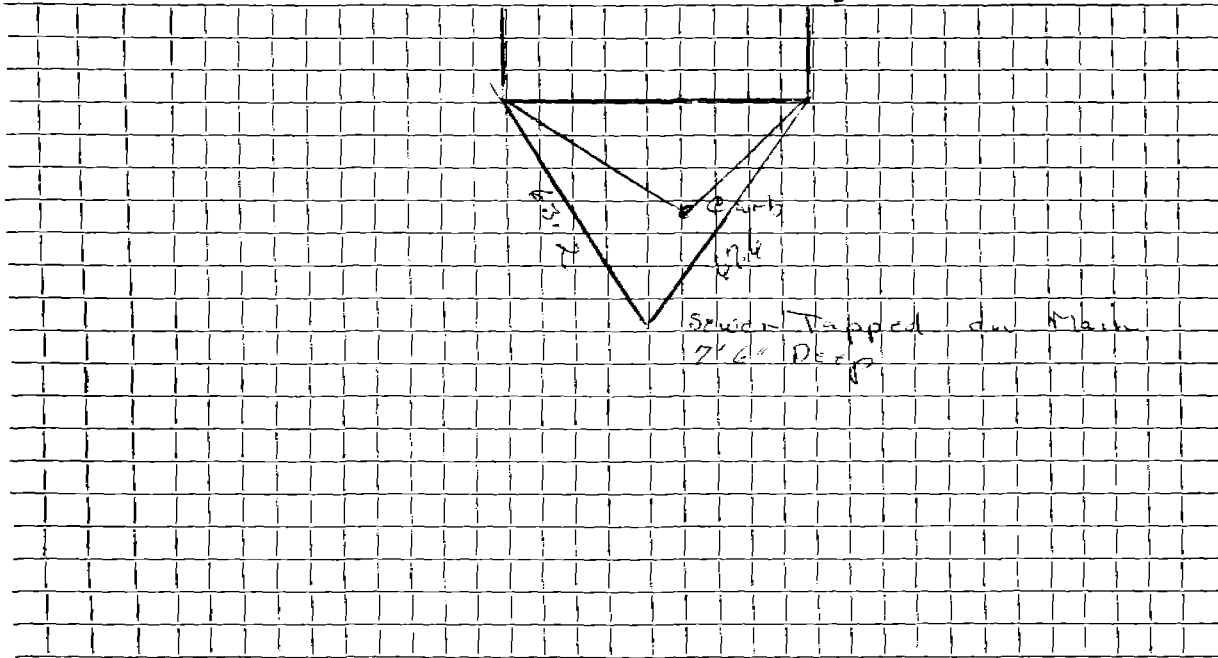

Connection made in ..... Street. Work completed .....

Remarks: .....  
.....  
.....