

Name *Furlys Paratore*

Service No. *32*

Address 11 Berwick Road

Location

Kind of Pipe

Size

Size of Main

~~Repair~~—~~Renewal~~—~~New Service~~ W.O.#2140.


5-29-74 Deposit Location *500.00* FEB 10 1975
2-10-75 Retard *144.88*
355.92

Date	Material	Amount	Total	Date	(NON-CHARGE)	Amount	
6-4-74	Labor	\$116.54		5-30-74	Labor	\$42.35	
6-5-74	"	38.00	\$154.54	5-31-74	"	169.57	
	10% O.H.	15.45	\$169.99	6-3-74	"	122.43	
49.5'	6" Transite Pipe @1.10		53.90	6-4-74	"	31.75	
2	5'x6" Transite Nipple w/coupling @1.41	14.10		6-5-74	"	30.87	\$396.97
1	1' x 6" Transite Nipple	2.51		10'	6" Transite Pipe @1.10	11.00	
1	6" x 6" Wye	9.35		1	6" x 8" C.I. Saddle	11.97	
1	6" Cap	2.55		1	6" x 6" Nipple	1.96	
1/4	Bag Cement	.54		1	90° el	5.13	
8	Bricks (Red) @.15	1.20		3	5' x 6" Nipple w/coupling @1.41	21.13	
1 1/2	Yds. Loam @6.00	9.00		15	Bricks @.03	.45	
15	lbs. seed @1.00	15.00		1/2	Bag Cement	1.08	
3 1/2	Ton Patch @12.15	42.53		9	Hrs. Trucking @3.00	27.00	
3	Hrs. Trucking @3.00	9.00		5 1/2	Hra. Town Shovel @6.50	35.75	
1	Hr. Roller	2.00		4	Hrs. Pick up	6.00	
3 1/2	Hrs. Town Shovel @6.50	22.75		1	Hr. Compressor	5.00	
1	Hr. Pick up	1.50				<i># 536.76</i>	
			<i>355.92</i>				

DATE _____

TOWN OF LEXINGTON — BOARD OF PUBLIC WORKS
SEWER DIVISION

Sketch of Service Here //

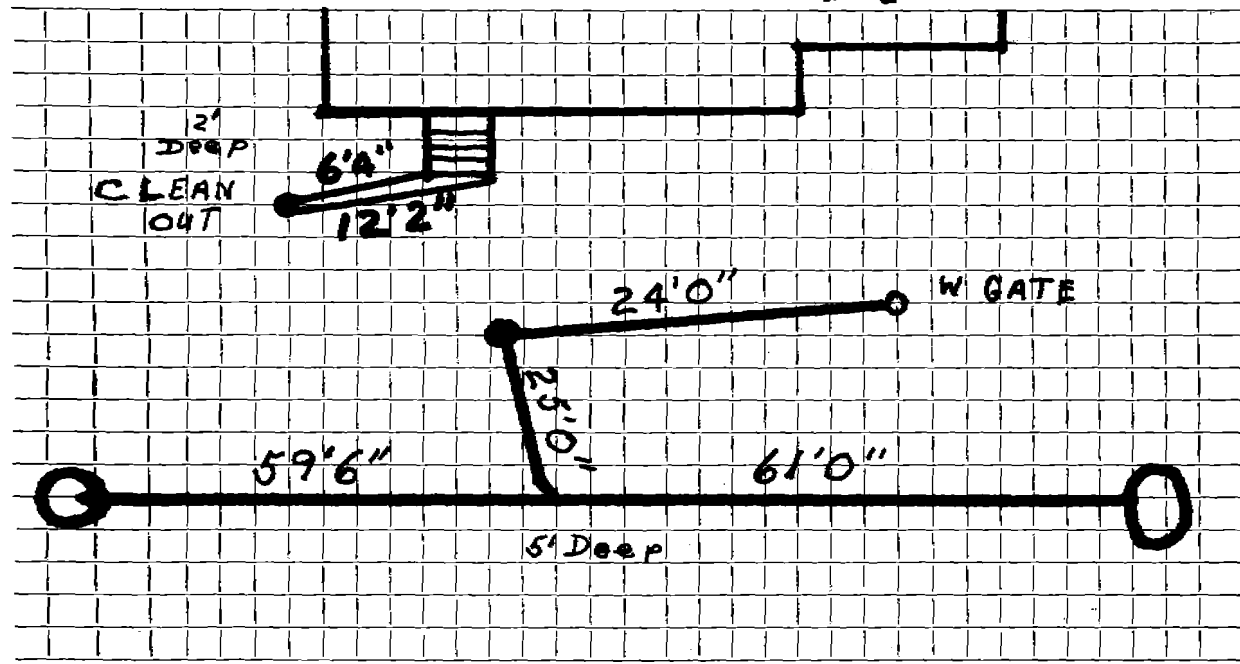

Connection made in Street. Work completed

Remarks: Original Service 11-30-53 - Service Tapped on Meriam St.