

Name Stephen P. Bradley

Service No. 27

Address 12 Berwick Road

Location

Kind of Pipe

Size

Size of Main

~~Repair/Remove~~ New Service

W. O. # 8548

Valve # 2018

Location


JUN 5 1972

Date	Material	Amount	Total	Date	Amount
4/19/72	Labor	84 04		3-3-72	350 00
5/15/72	"	33 26		6-5-72	118 97
	10% O.H.	11 73	129 03		231 23
28'	6" Transite pipe .90		25 20		
1	12" Nipple		1 71		
1	90o Elbow		5 65		
1	6" Plug		2 38		
12	Brick .07 each		84		
1 1/2	Bag cement 1.95		98		
3	Couplings 1.78		5 34		
1 1/2	Ton cold patch 8.00		12 00		
2	Ton Hot Top 7.45		14 90		
3	Hrs. Trucking 3.00		9 00		
2	" " 1.50		3 00		
2	Hrs. Shovel 6.50		13 00		
1	Hr. Compressor		5 00		
1/2	Hr. Roller 2.00		1 00		
	Trailer		2 00		
4/21/72	85' 6" Transite pipe		231 03		
	10' 4" Cast Iron pipe				

Deposit
Refund

DATE _____

TOWN OF LEXINGTON — BOARD OF PUBLIC WORKS
SEWER DIVISION

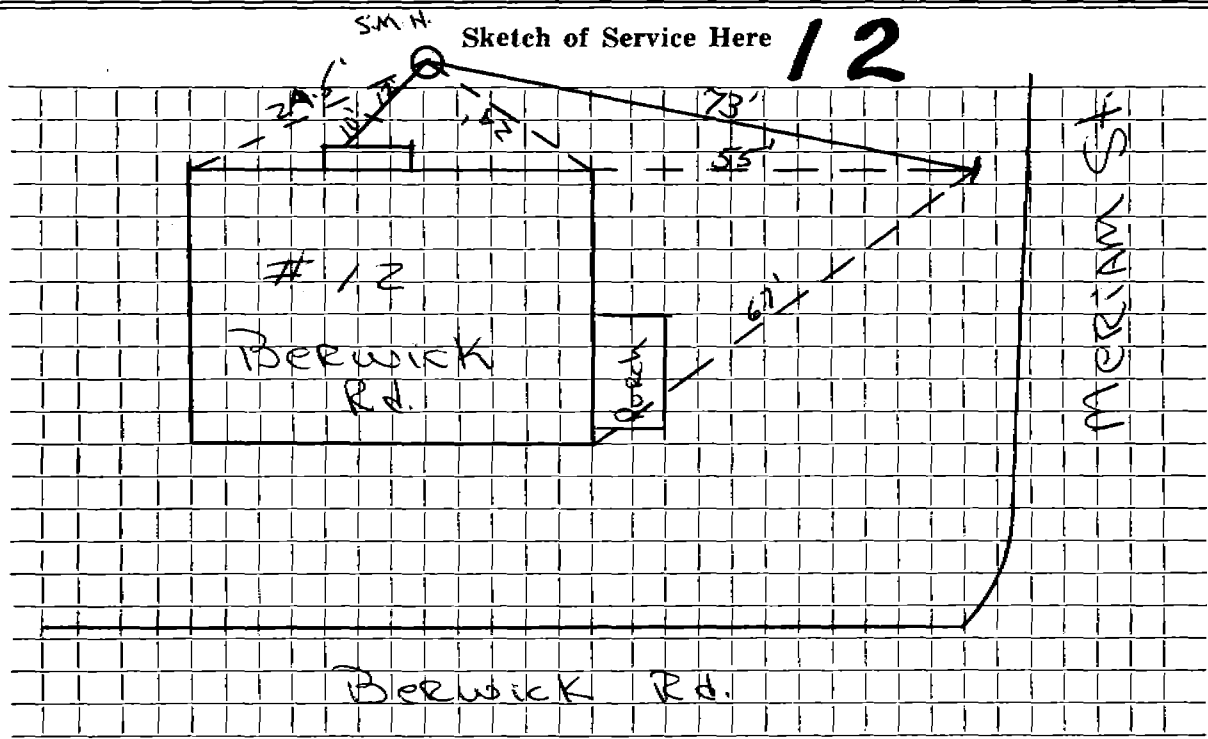

Connection made in Street. Work completed

Remarks:
.....
.....