

Name Guy E. Reed, Jr.

Service No. 46

Address 2 Berwick Road

Location

Kind of Pipe

Size

Size of Main

~~Repair~~—Renewal—~~NEW SERVICE~~

W.O.#812

Location NOV 19 1973

Date	Material	Amount	Total	Date	Amount
5/22/73	Labor 71.60			5-21-73	380 00
5/29/73	" 25.01	96.61		11-30-73	34 87
	10% O.H.	9.66	106.27		304 87
30'	6" Transite @.99		29.70		
1	Donut		3.05		
3	yds. Loam @5.00		15.00		
5	lbs. Grass Seed @.95		4.75		
	Sidewalk Patch 14 x 5		46.80		
	Street Patch 20 x 6		79.80		
5	hrs. Trucking @3.00		15.00		
3	hrs. Pickup @1.50		4.50		
			<u>\$ 304.87</u>		
				5-13-73	Solids


Deposit  
Paid

DATE \_\_\_\_\_

TOWN OF LEXINGTON — BOARD OF PUBLIC WORKS  
SEWER DIVISION

Sketch of Service Here

2

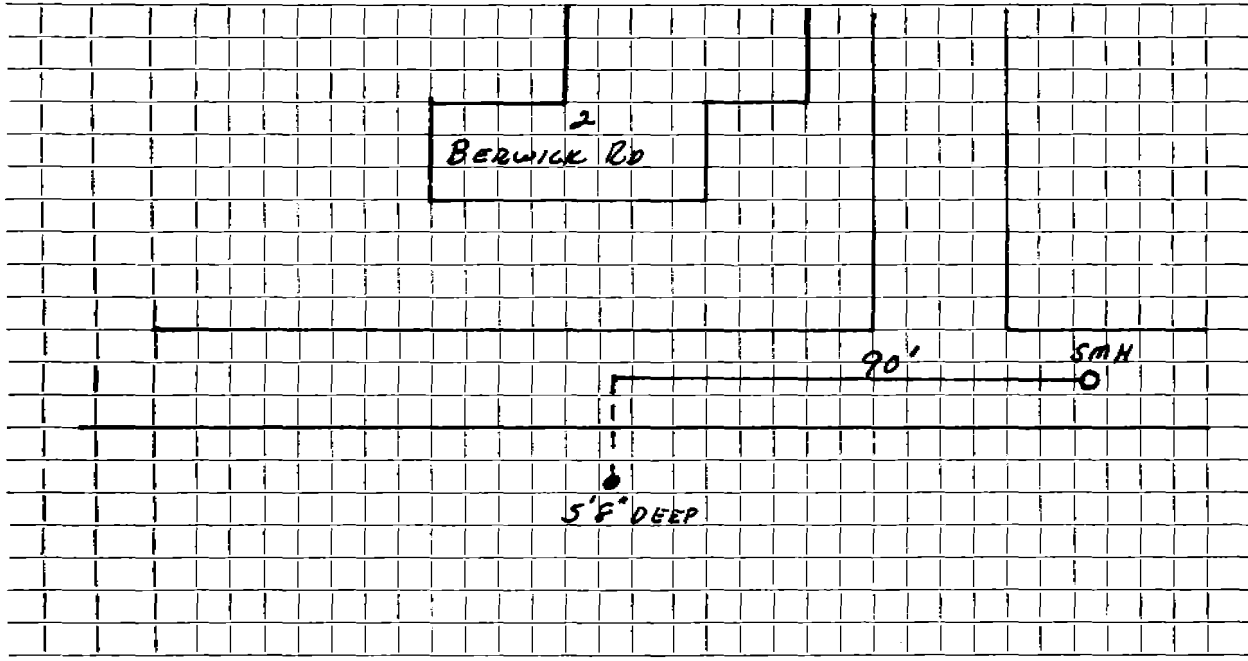

Connection made in ..... Street. Work completed .....

Remarks: Original Service 6-5-31 .....

.....  
.....