


DATE 5/13/80

TOWN OF LEXINGTON — BOARD OF PUBLIC WORKS
SEWER DIVISION

Sketch of Service Here

4

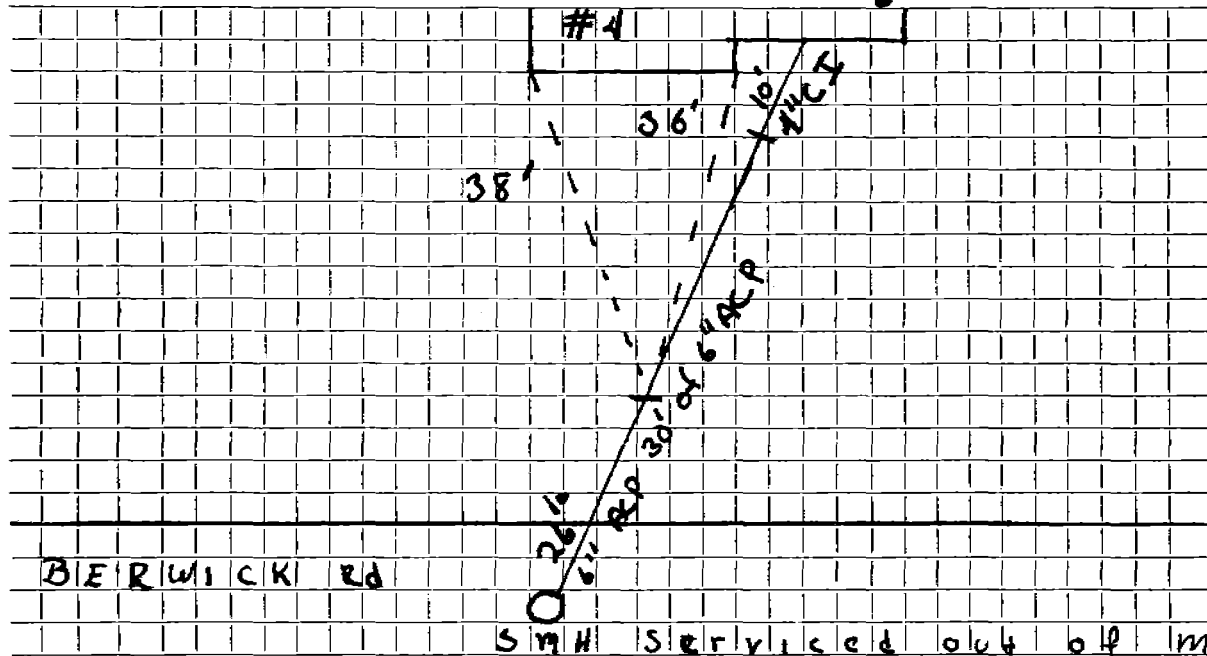

SMH serviced out of man hole

Connection made in Street. Work completed

Remarks:
.....
.....