

Name **Bertha Hutchinson**Service No. **10**Address **5 Berwick Road****Lexington., Mass.**

Location

Kind of Pipe **Com. June 14, 1948**

Size

Size of **Main**

Repair—Renewal—New Service

Location

Date	Material	Amount	Total	Date	Amount
May 19, '48	Labor	47 72		May 7 '48 Deposited	150.00
20	"	7 40	55 12	June 17 '48 Refunded	32.79
	10% Overhead		5 51		117.21
	44'-6" Sewer Pipe @ .26		11 44		
	Joint Compound		2 64		
	Littlefield Shovel 2 hrs.		14 00		
	Hough Loader 1 hr. @ 3.00		3 00		
	Trucking 2 hrs. @ .75		1 50		
	Patching 19 x 3		19 00		
			112 21		
	Labor				

TOWN OF LEXINGTON—DEPT. OF PUBLIC WORKS

SEWER DIVISION

DATE

NO.


The undersigned **applies** for the construction of a particular sewer connecting No. Street and hereby **agrees** to comply with the Rules and Regulations governing the construction and use of Particular Sewers, as now or **at any** future time established by the Board of Selectmen.

Am't of estimate \$

Am't Paid \$

..... Owner

Sketch of Service Here

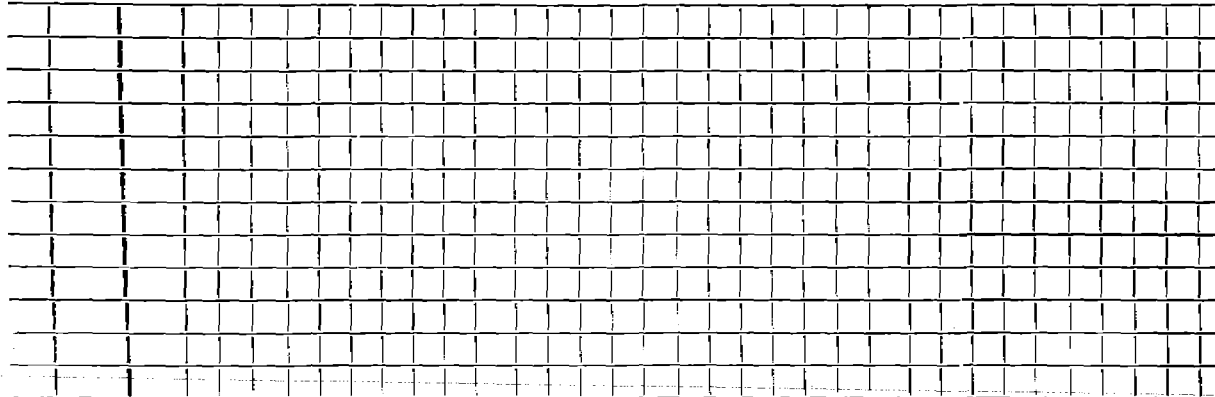

Connection made **in** Street.

Work completed 19..

Remarks: