

Name Roger P. Downey

Service No. 245

Address 6 Berwick Road

Location

Kind of Pipe

Size

Size of Main

~~Repair or Renewal~~—New Service W.O. #1337 -#1978 Trebino Const. Permit#a124

Location

JUN 27 1966

Date	Material	Amount	Total	Date	Amount
12-6-65	Labor 68.76			11-23-65	125.00
3-24-66	Labor 11.49			7-6-66	31.94
3-26-66	Labor 14.33	94.58			
	10% O.H.	9.46	104.04		
20'	6" Transite pipe @ .82		16.40		
3	Hrs. Town Shovel @ 6.50		19.50		
3	Hrs. Trucking @ 3.00		9.00		
1/2	Hr. Trailer @ 2.00		1.00		
1/2	Hr. small roller @ 3.00		1.50		
1	Ton Hot top		5.50		
			156.94		
12-7-65	64' 6" Transite pipe				

Deposit Paid


DATE _____

TOWN OF LEXINGTON — BOARD OF PUBLIC WORKS

SEWER DIVISION

Sketch of Service Here

6

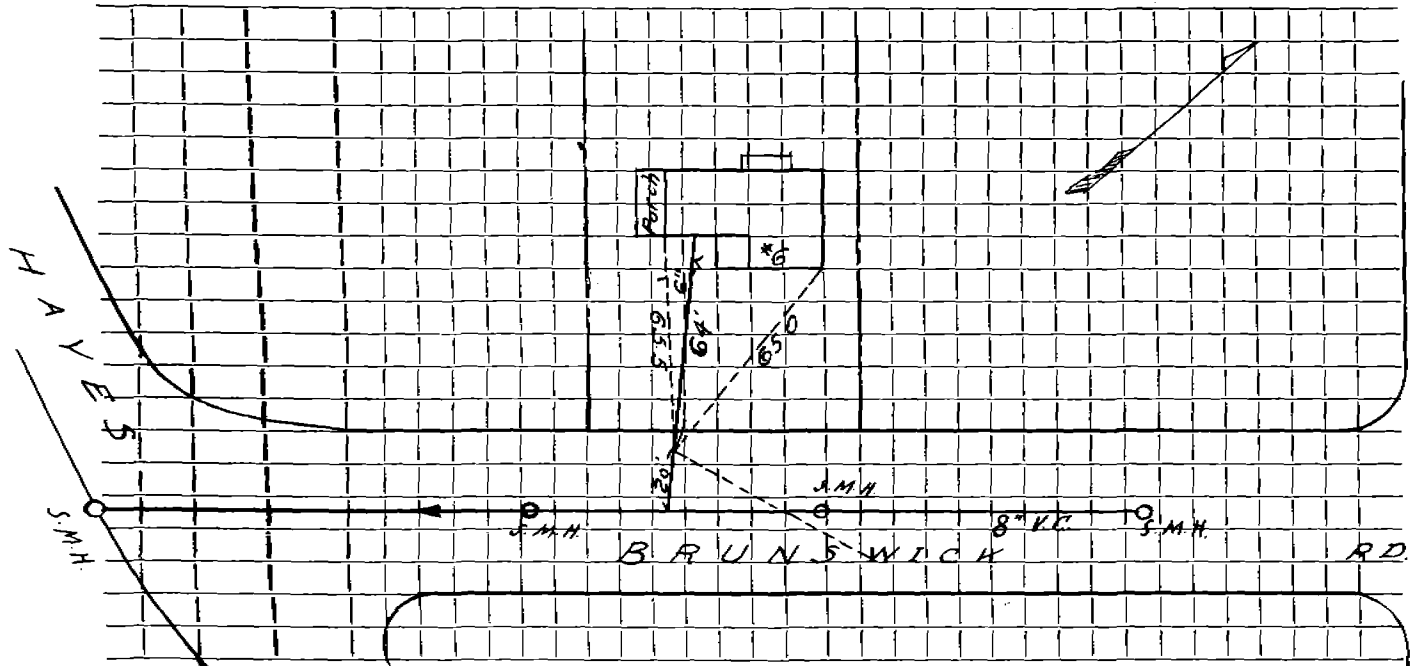

Connection made in Street. Work completed

Remarks:
.....
.....