

Name Colby Kelley

Service No. 97

Address 9 Berwick Road

W.O. # 8836

Location

Kind of Pipe Permit #22

Size

Size of Main

~~XXXXXX~~ New Service John Devine - 19 Slocum Rd., Lexington

Location

DEC 28 1964


Date	Material	Amount	Total	Date	Amount
6-26-64	Labor 2.65			6-17-64	125 00
6-29-64	" 29.44			1-5-65	7 06
6-30-64	" 14.83	46.92			132 06
	10% O.H.	4 69	51 61		
	20' 6" Transite Pipe @.82		16 40		
	1 Bag Cement		1 50		
	7 1/2 Yds. Fill @1.00		7 50		
	15 1/2 Yds. Gravel @1.10		17 05		
	14 X 3 Patch		14 00		
	2 Hrs. Town Shovel @6.50		13 00		
	2 Hrs. Town Truck		6 00		
	1 Hr. Compressor @5.00		5 00		
			132 06		
9-15-64	58' 6" Transite Pipe				

DATE _____

TOWN OF LEXINGTON — BOARD OF PUBLIC WORKS
SEWER DIVISION

Sketch of Service Here

9

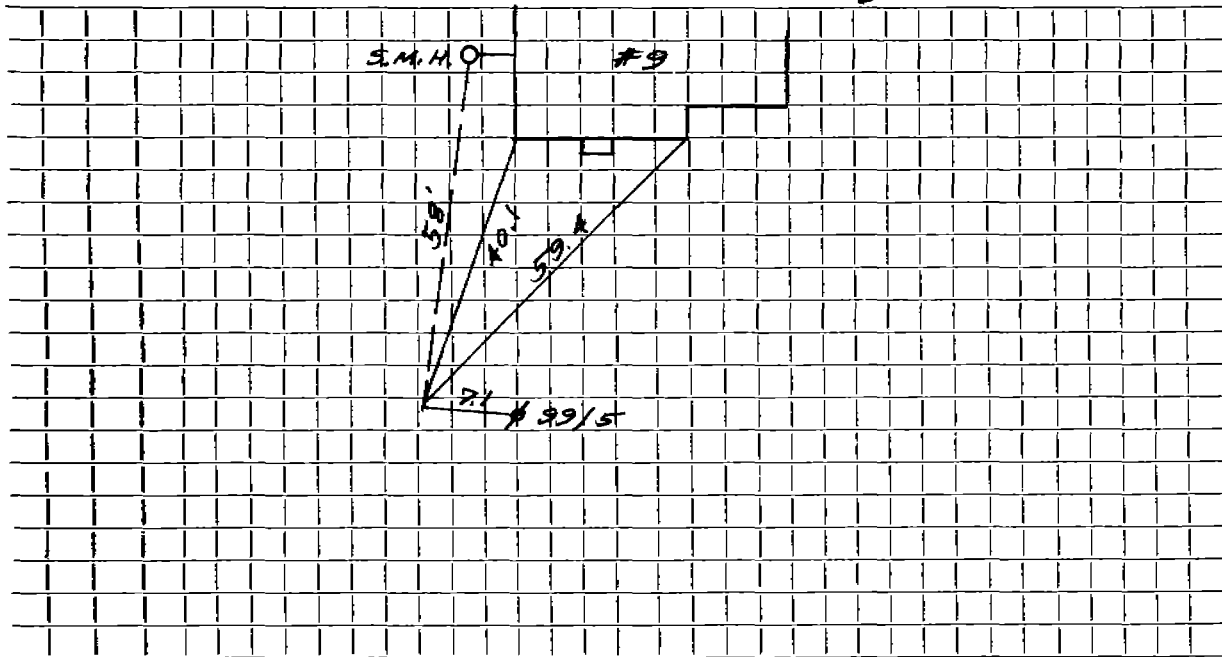

Connection made in Street. Work completed

Remarks:

.....

.....