

Name *Kerri Realty Trust*

Service No.

Address *10 Bicentennial Drive*

Location

Kind of Pipe

Size

Size of Main

Repair—Renewal—New Service *Eagle #3100*

Location

Date	Material	Amount	Total	Date	Amount
------	----------	--------	-------	------	--------

<i>11/30/78</i>	<i>32'</i>	<i>6" Transite Pipe</i>			
-----------------	------------	-------------------------	--	--	--


	<i>10'</i>	<i>4" Cast Iron Pipe</i>			
--	------------	--------------------------	--	--	--

DATE \_\_\_\_\_

TOWN OF LEXINGTON — BOARD OF PUBLIC WORKS  
SEWER DIVISION

Sketch of Service Here

10

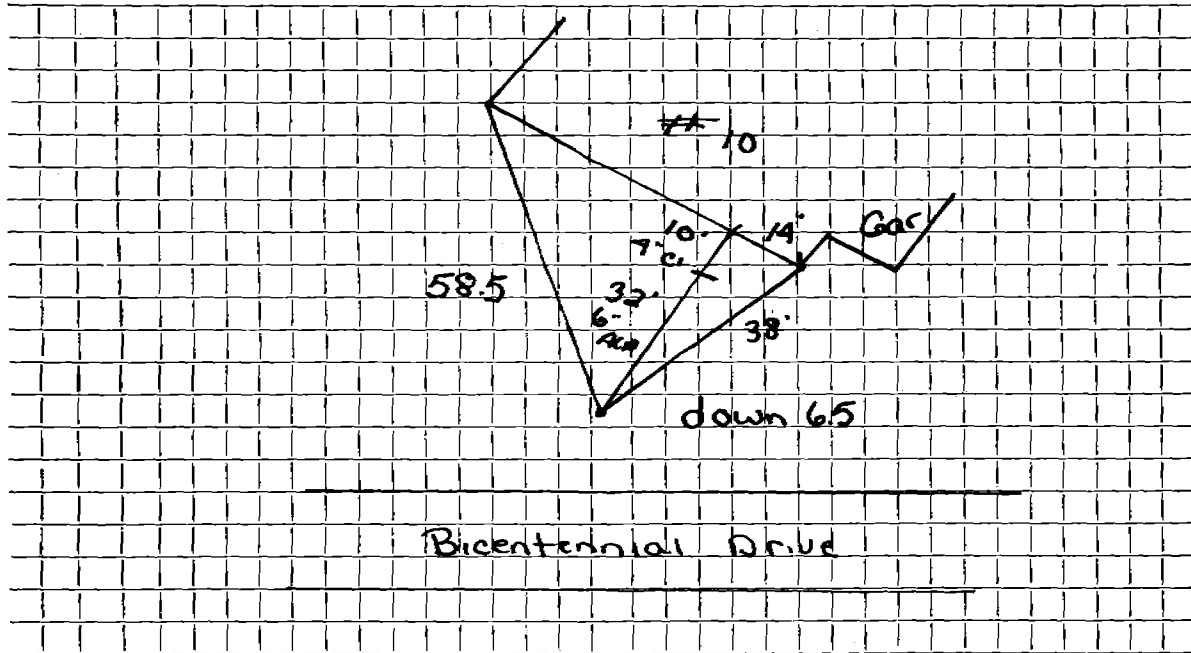

Connection made in ..... Street. Work completed .....

Remarks: .....  
.....  
.....