

Name Kerry Realty Tr.

Service No.

Address 16 Bicentennial Drive

Location

Kind of Pipe

Size

Size of Main

~~Repair/Replace~~ New Service Dave Eagle #3007

Location

Date	Material	Amount	Total	Date	Amount
------	----------	--------	-------	------	--------


7/26/77	6" transite pipe				
---------	------------------	--	--	--	--

10'	4" cast iron pipe				
-----	-------------------	--	--	--	--

DATE _____

TOWN OF LEXINGTON — BOARD OF PUBLIC WORKS
SEWER DIVISION

Sketch of Service Here **16**

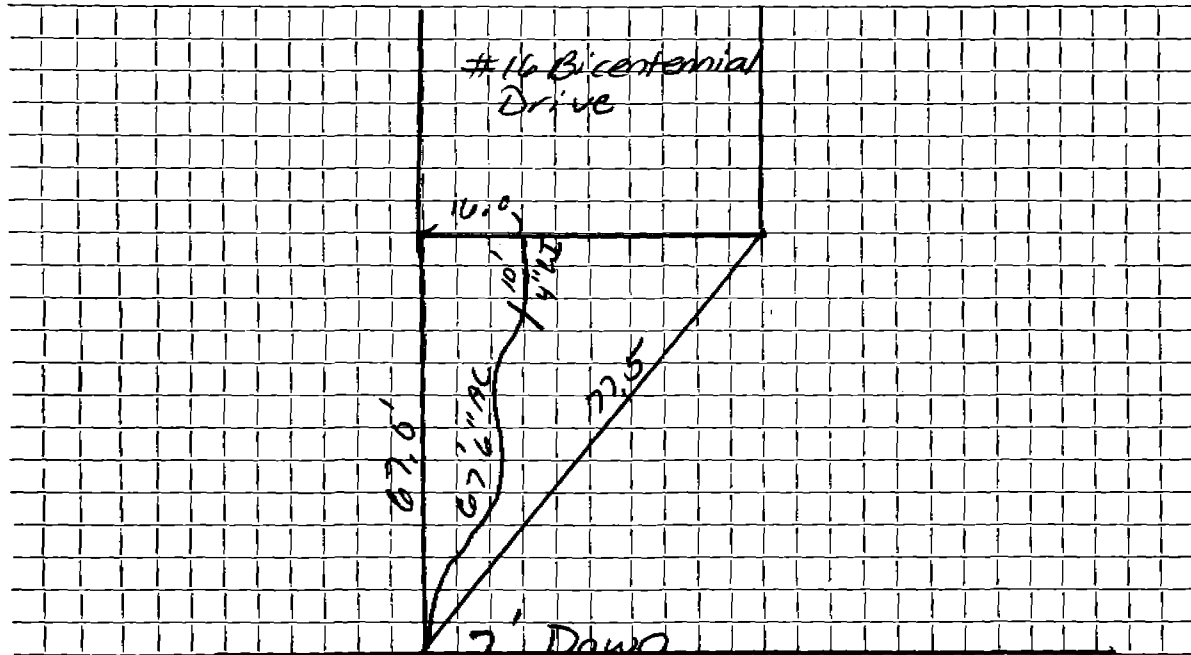

Connection made in Street. Work completed

Remarks:
.....
.....