


TOWN OF LEXINGTON — BOARD OF PUBLIC WORKS
SEWER DIVISION

Sketch of Service Here **17**

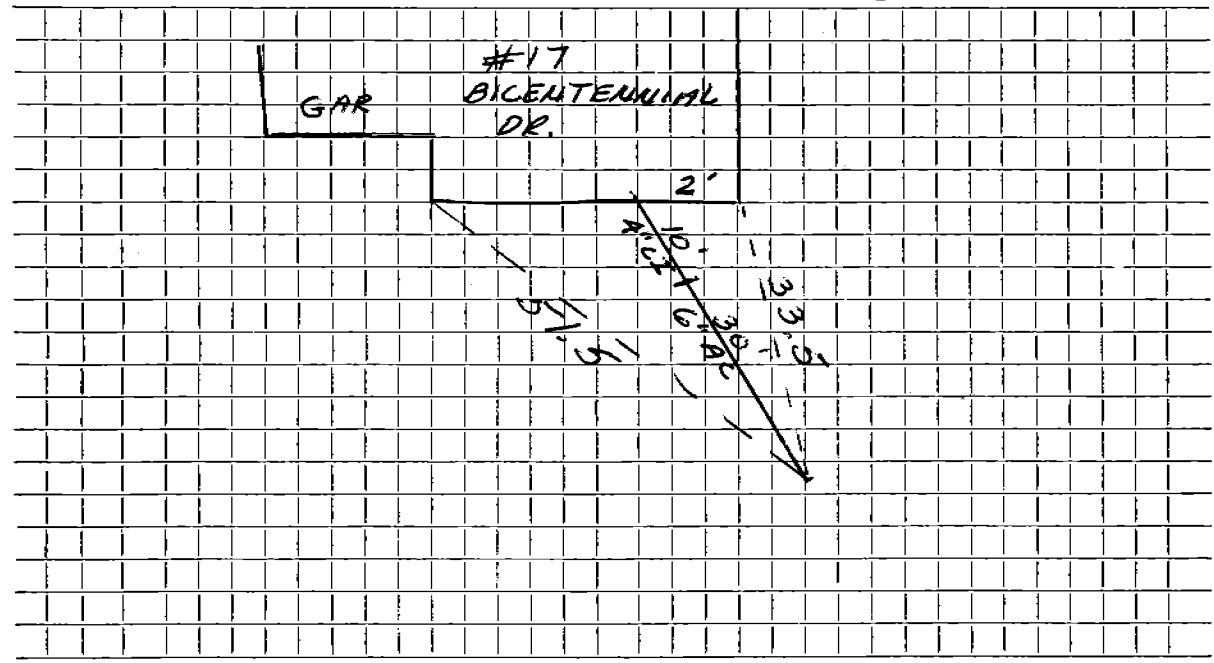

Connection made in BICENTENNIAL D.R. Street Work completed

Remarks: WATER & SEWER IN SAME TRENCH

.....
.....