


DATE _____

TOWN OF LEXINGTON — BOARD OF PUBLIC WORKS

SEWER DIVISION

Sketch of Service Here

2

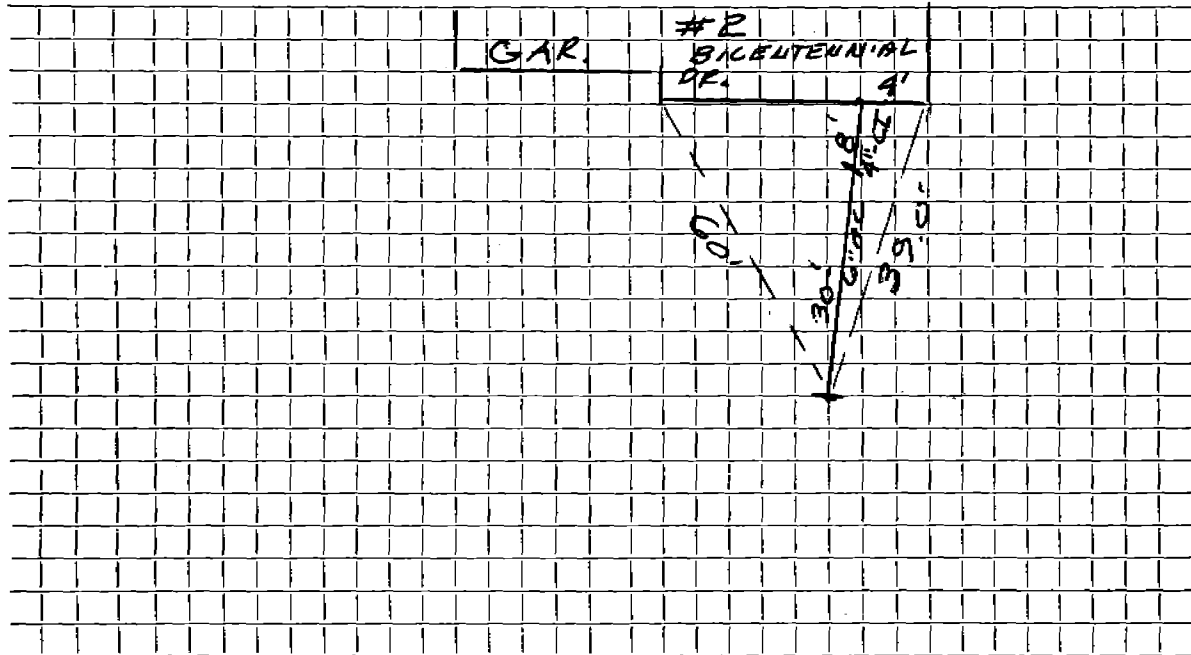

Connection made in BICENTENNIAL DR. Street.

Work completed

Remarks:

.....

.....