

Name Kerrie Realty Trust

Service No.

Address 9 Bicentennial Drive

Location

Kind of Pipe

Size

Size of Main

~~Repair/Renewal~~ New Service Dave Eagle #3009

Location


Date		Material	Amount		Total		Date		Amount	
8/3/77	41'	6" transite pipe								
	10'	4" cast iron								

DATE _____

TOWN OF LEXINGTON — BOARD OF PUBLIC WORKS

SEWER DIVISION

Sketch of Service Here **9**

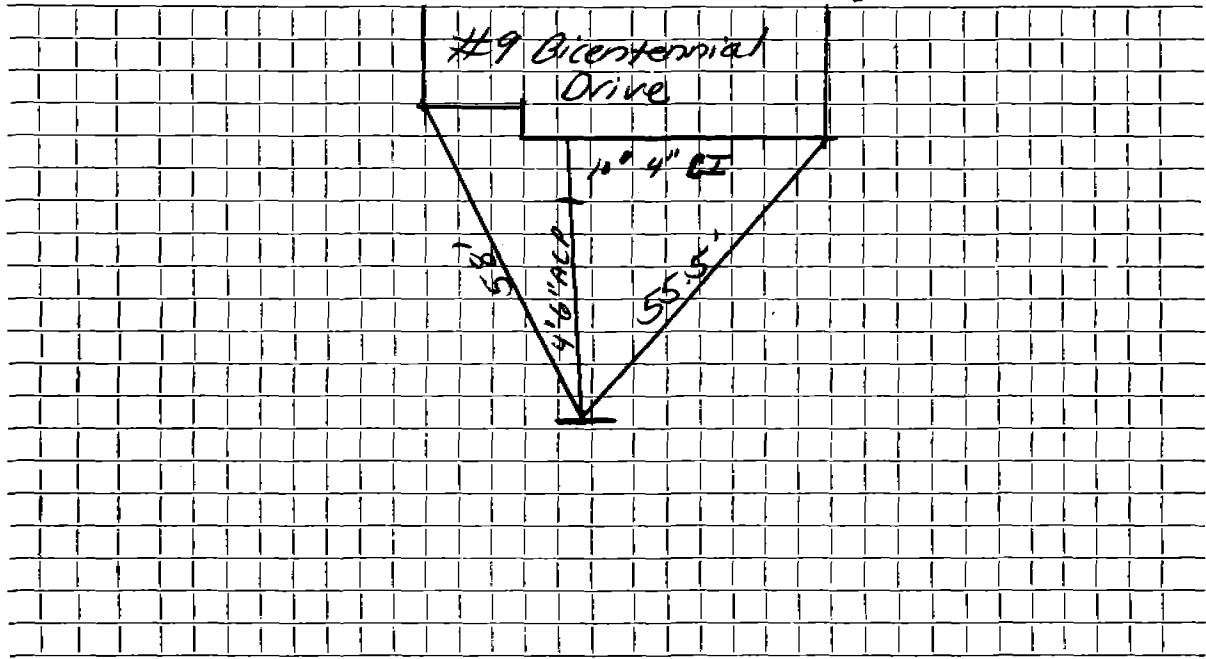

Connection made in Street. Work completed

Remarks:
.....
.....