

Name J. Frank Busa

Service No.

Address 11 Birch Hill Lane

Lot #24

Location

Kind of Pipe

Size

Size of Main

Repair—Renewal—New Service

Lucente #795 David Eagle #1101

Location

Date	Material	Amount	Total	Date	Amount
------	----------	--------	-------	------	--------

1968	30'	6" Transite pipe			
------	-----	------------------	--	--	--

9/10/68	34'	6" Transite pipe			
---------	-----	------------------	--	--	--


	10'	4" Cast Iron			
--	-----	--------------	--	--	--

				1-16-97	Service blocked at the connection to main - GREASE and more GREASE Respond (SEE REPORTS)
--	--	--	--	---------	---

DATE \_\_\_\_\_

TOWN OF LEXINGTON — BOARD OF PUBLIC WORKS  
SEWER DIVISION

Sketch of Service Here **11**

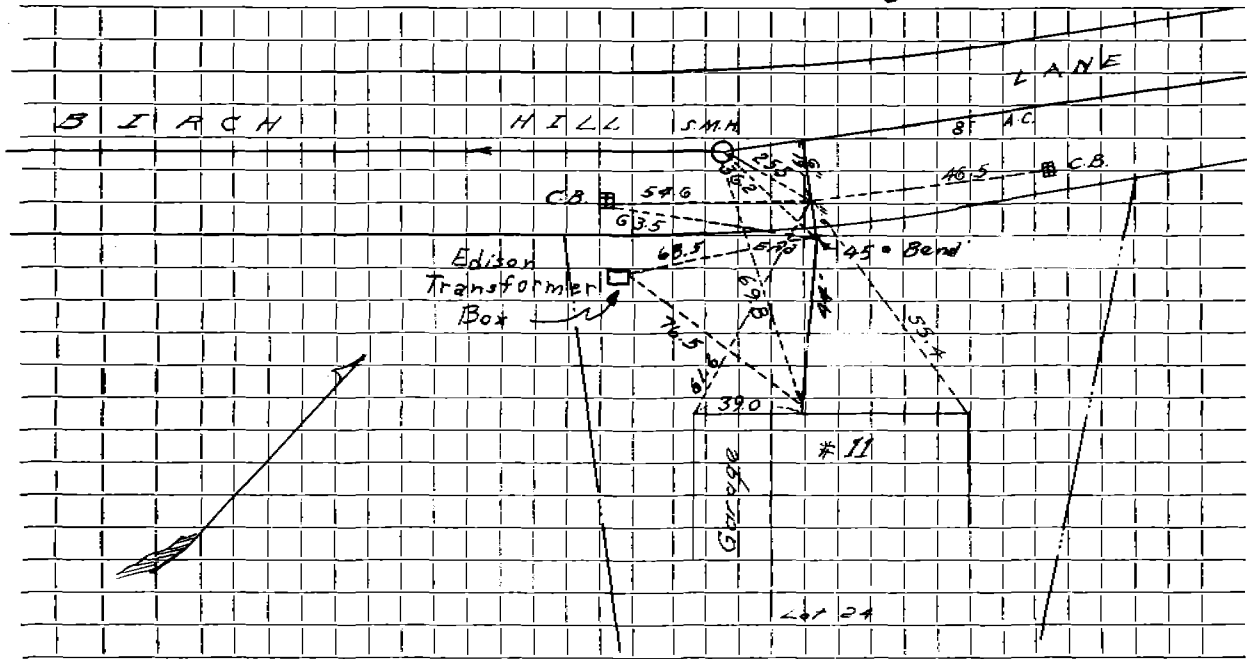

Connection made in ..... Street. Work completed .....

Remarks: .....  
.....  
.....