

Name J. Frank Busa

Service No.

Address 15 Birch Hill Lane

Lot #23

Location

Kind of Pipe

Size

Size of Main

Repair—Renewal—New Service J. M. Lucente #797

Location

Date

Material

Amount

Total

Date

Amount


1968 23' 6" Transite pipe

DATE _____

TOWN OF LEXINGTON — BOARD OF PUBLIC WORKS
SEWER DIVISION

Sketch of Service Here

15

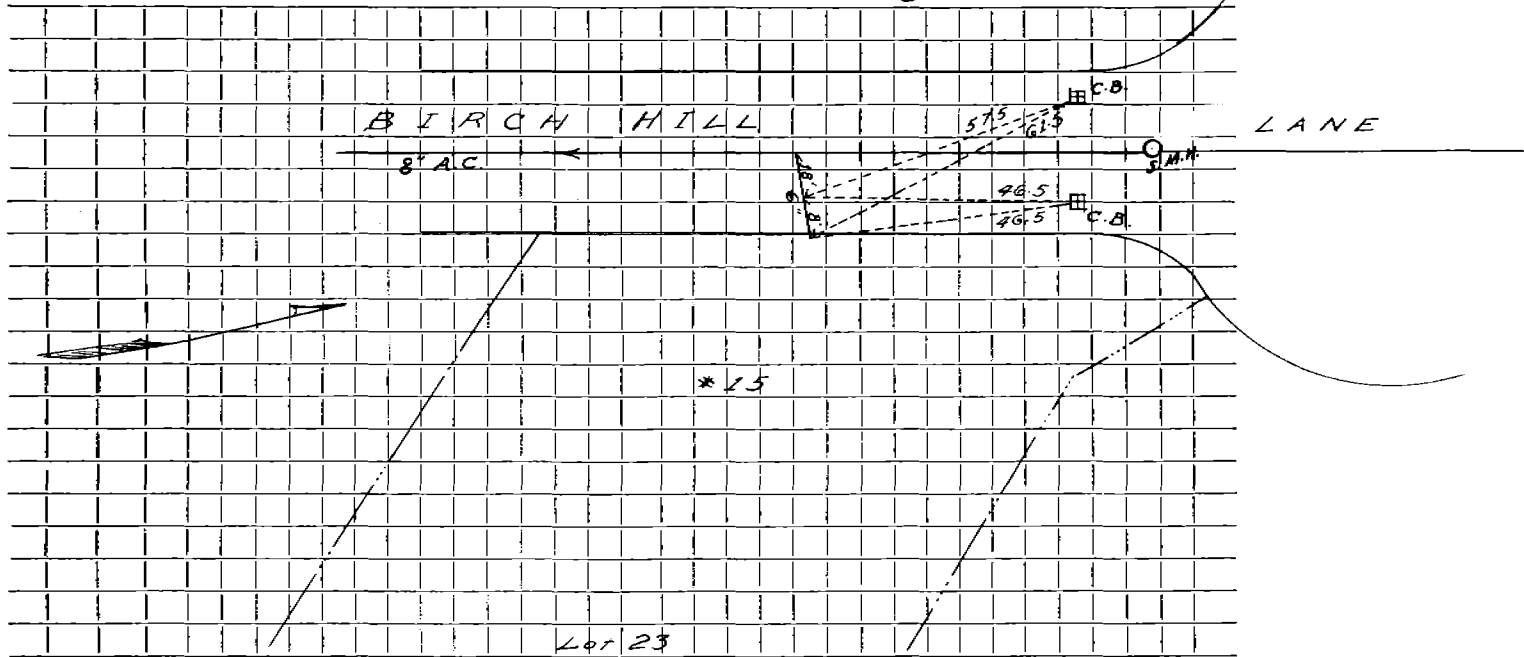

Connection made in Street. Work completed

Remarks:
.....
.....