

Name J. Frank Busa

Service No. \_\_\_\_\_

Address 16 Birch Hill Lane

Lot #18

Location \_\_\_\_\_

Kind of Pipe Ferrari<sup>1</sup> #1629

Size

Size of Main

Repair—Renewal—New Service Lucente #798

Location


Date		Material	Amount	Total	Date		Amount
1968	35'	6" Transite pipe					
8-18-70	46'	6" Transite pipe					
	10'	4" Cast Iron pipe					

DATE \_\_\_\_\_

TOWN OF LEXINGTON — BOARD OF PUBLIC WORKS  
SEWER DIVISION

Sketch of Service Here

16

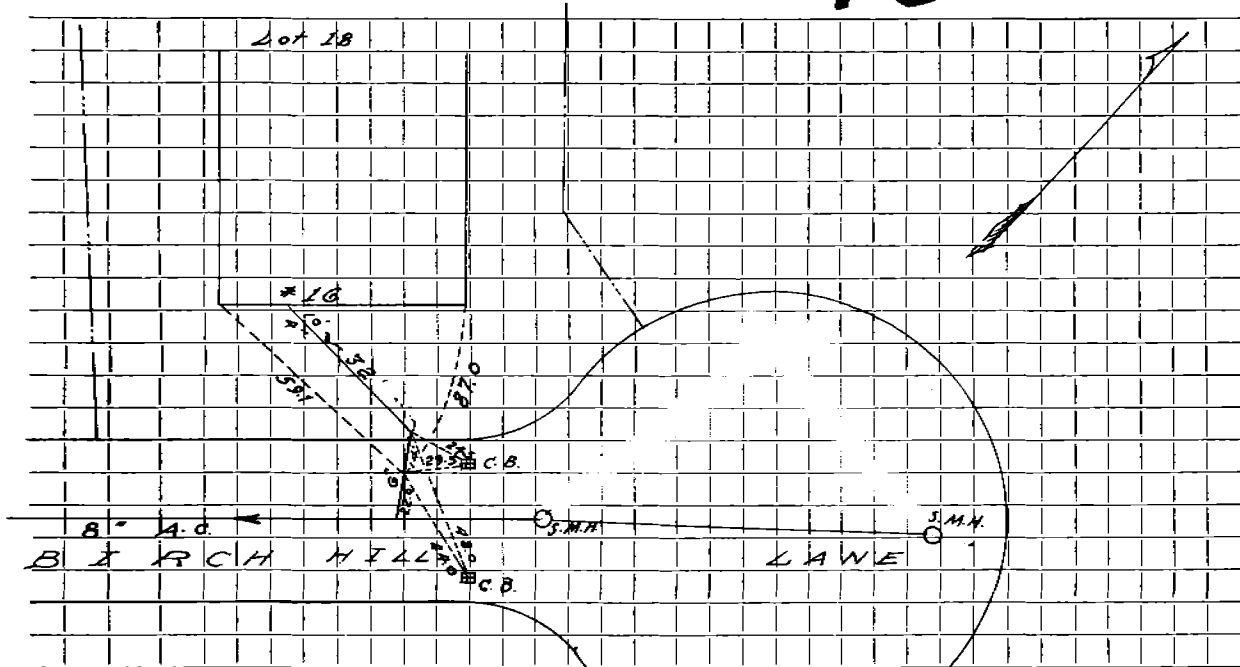

Connection made in ..... Street. Work completed .....

Remarks: .....  
.....  
.....