

Name J. Frank Busa

Service No.

Address 17 Birch Hill Lane

Location

Kind of Pipe

Size

Size of Main

Repair—Renewal—New Service Glynn #1270


Location

Date		Material	Amount		Total		Date		Amount	
12-6-68	46'	6" Transite pipe								
	10'	4" Cast Iron pipe								

DATE _____

TOWN OF LEXINGTON — BOARD OF PUBLIC WORKS
SEWER DIVISION

17 Sketch of Service Here

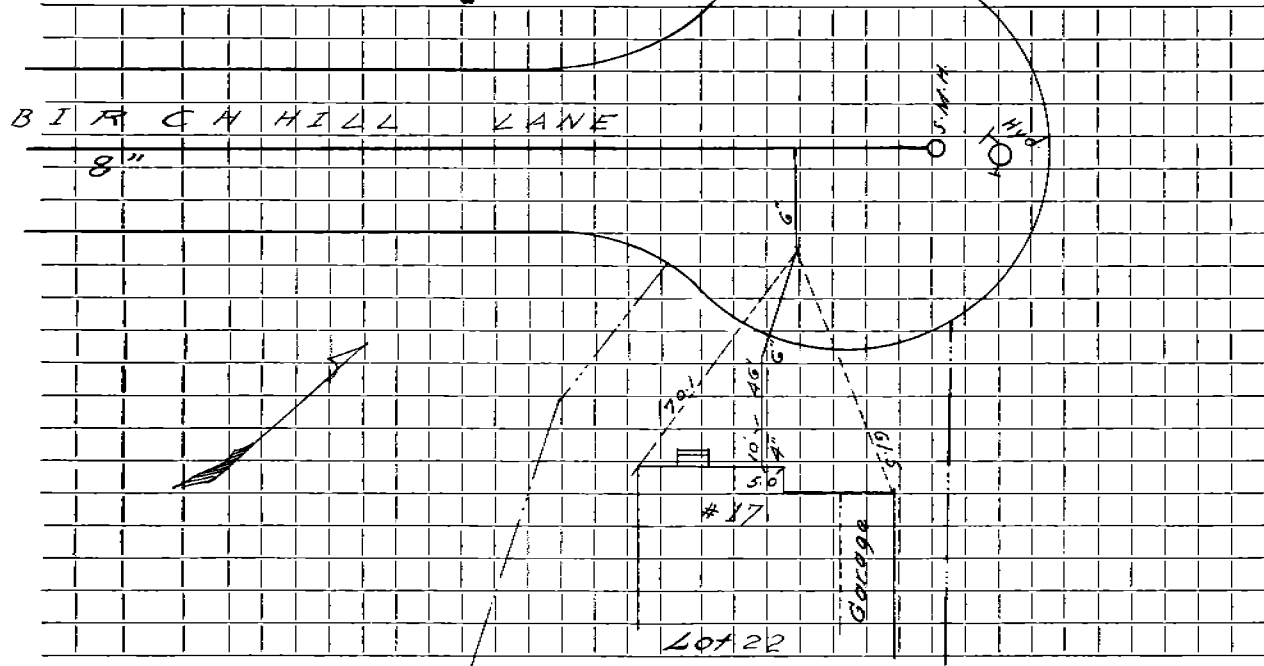

Connection made in Street. Work completed

Remarks:
.....
.....