




DATE \_\_\_\_\_

# TOWN OF LEXINGTON — BOARD OF PUBLIC WORKS

## SEWER DIVISION

Sketch of Service Here **18**

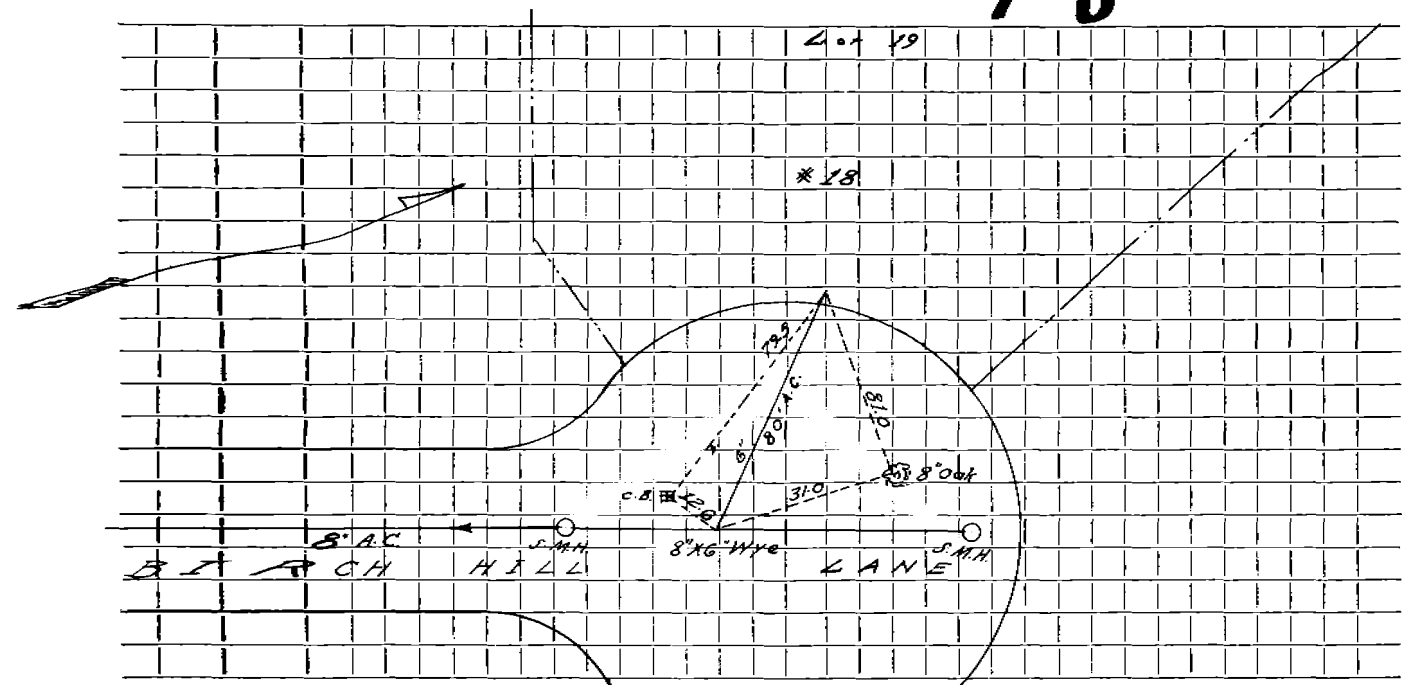

Connection made in ..... Street. Work completed .....

Remarks: Is. Connected To Sewer. - Dye Test Used. 9/29/97.....

OWNER did. Work. 6" of 2" PVC. NOT INSPECTED BY TOWN.....