

Name J. Frank Busa

Service No.

Address #6 Birch Hill Lane

Location

Kind of Pipe

Size

Size of Main

Repair—Renewal—New Service

Lucente #775

Location


Date		Material	Amount		Total		Date		Amount	
4-26-68	30'	6" Transite								
5-24-68	54'	6" Transite								

DATE \_\_\_\_\_

TOWN OF LEXINGTON — BOARD OF PUBLIC WORKS

SEWER DIVISION

Sketch of Service Here **6**

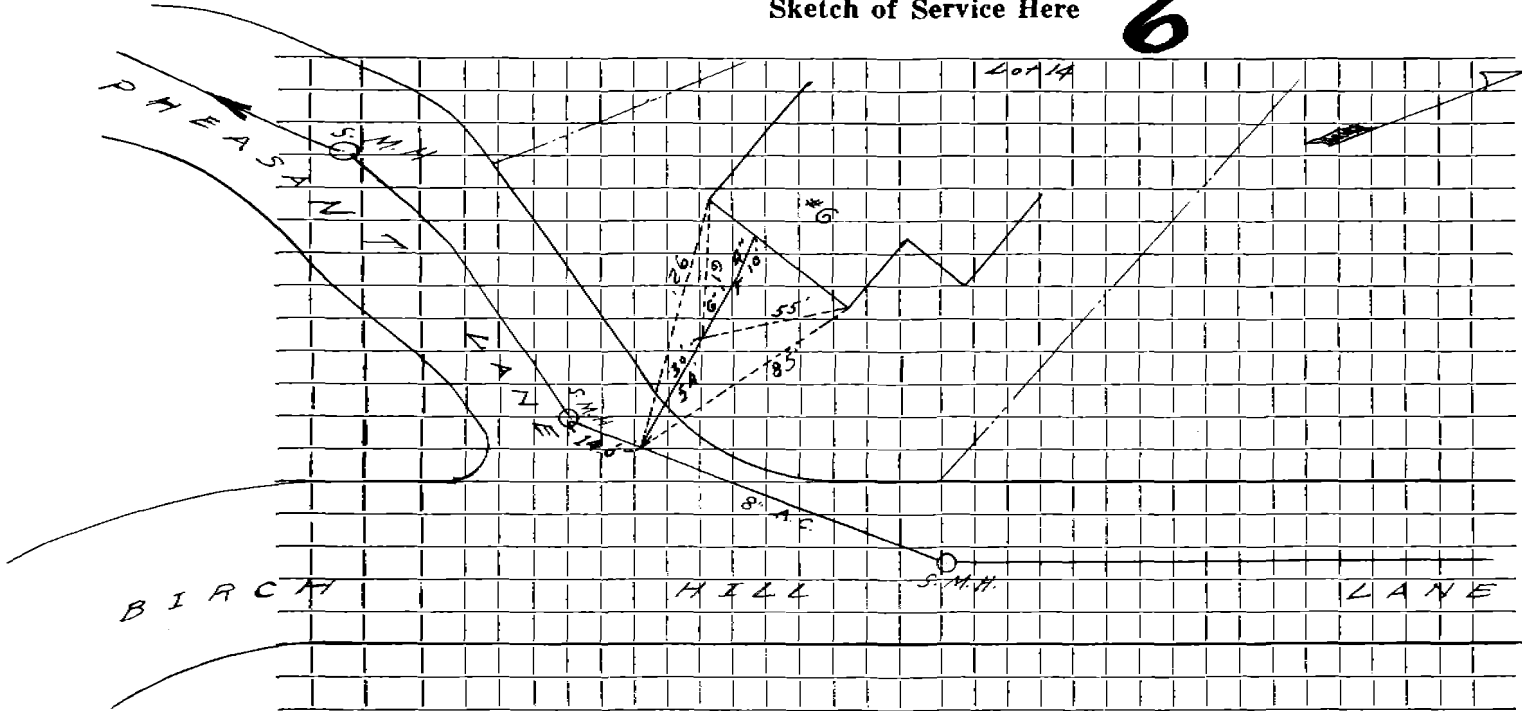

Connection made in ..... Street. Work completed .....

Remarks: .....  
.....  
.....