


DATE 8/6/80

TOWN OF LEXINGTON — BOARD OF PUBLIC WORKS
SEWER DIVISION

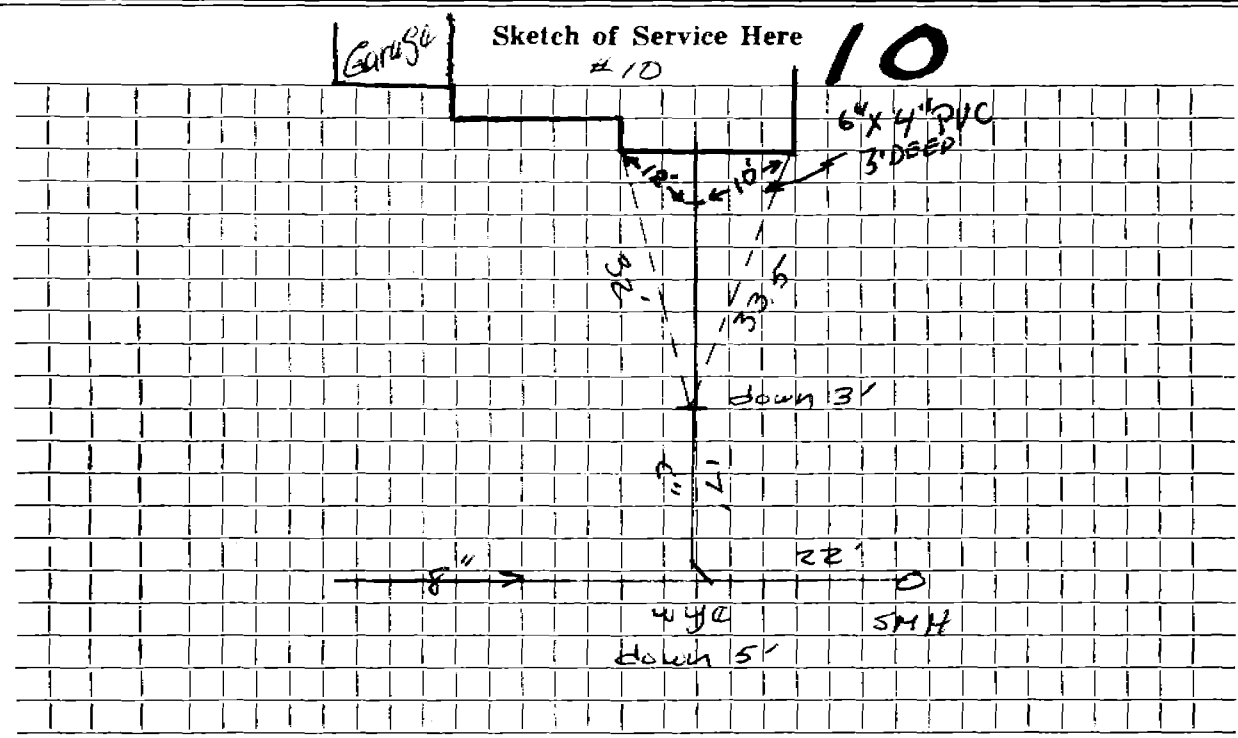

Connection made in BIRD HILL RD. Street. Work completed

Remarks:

.....

.....