


DATE 8/7/80

TOWN OF LEXINGTON — BOARD OF PUBLIC WORKS
SEWER DIVISION

15

Sketch of Service Here

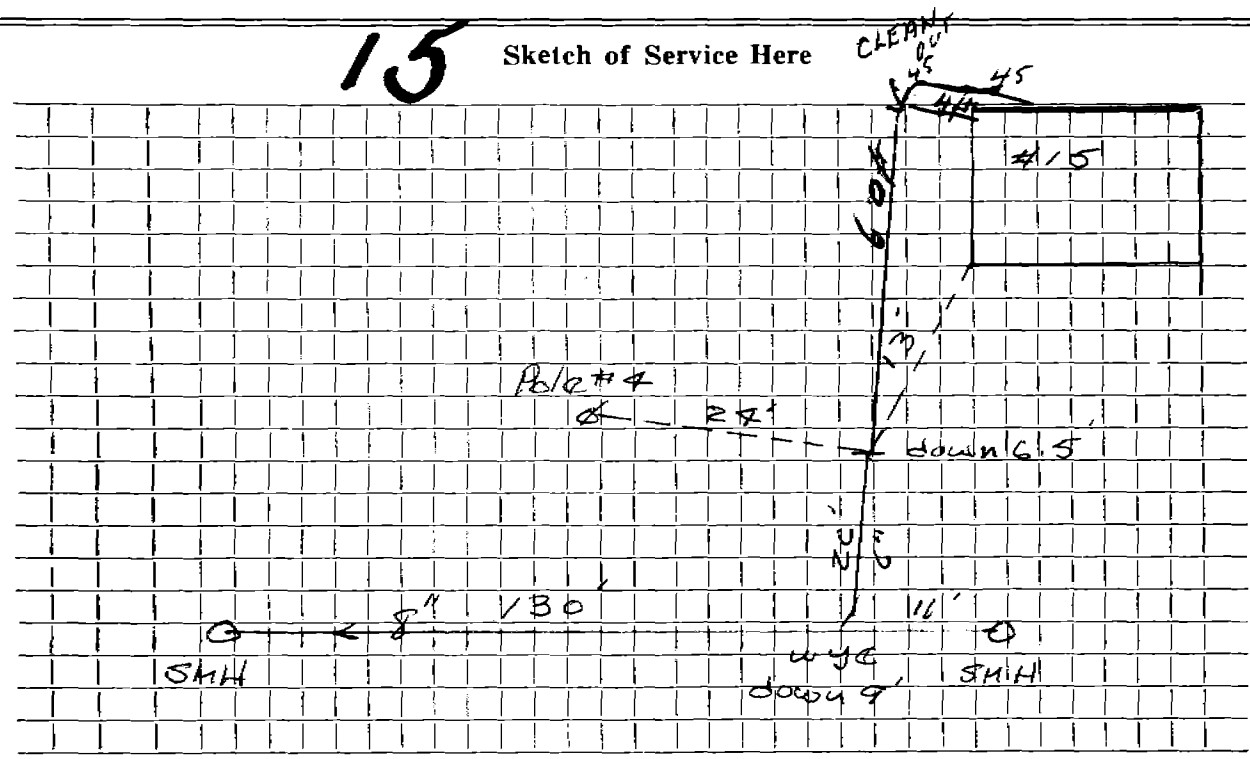

Connection made in BIRD HILL RD. Street. Work completed

Remarks:
.....
.....