




DATE 8/7/80

TOWN OF LEXINGTON — BOARD OF PUBLIC WORKS  
SEWER DIVISION

Sketch of Service Here

16

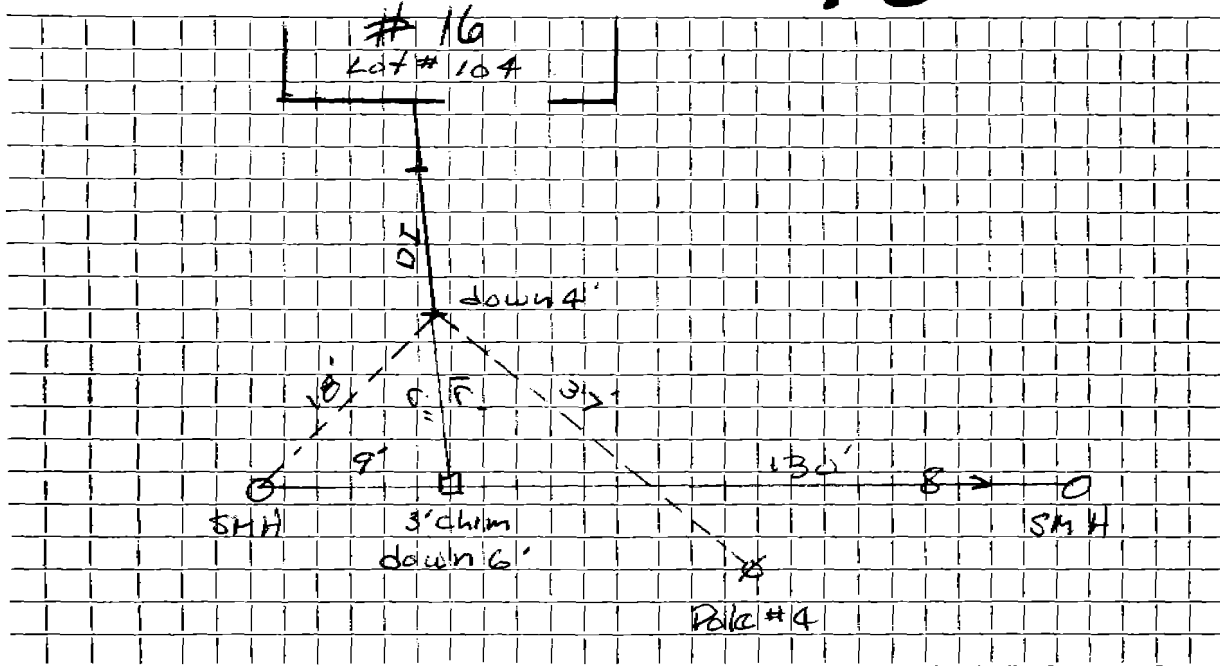

Connection made in BIRD HILL RD, Street. Work completed .....

Remarks: .....

.....

.....