

Name

Service No.

Address 20 BIRD HILL ROAD

Location

Kind of Pipe

Size

Size of Main

Repair ~~Renewal~~ New Service

Location

Date	Material	Amount	Total	Date	Amount
------	----------	--------	-------	------	--------

4-17-02


55' 6" PVC  
6x6 PVC - TRASITE FERNCO  
9' 4" PVC  
1 45° BEND SWEEP  
1 WYE

OUTSIDE TRASITE

DATE \_\_\_\_\_

**TOWN OF LEXINGTON — BOARD OF PUBLIC WORKS**  
**SEWER DIVISION**

Sketch of Service Here

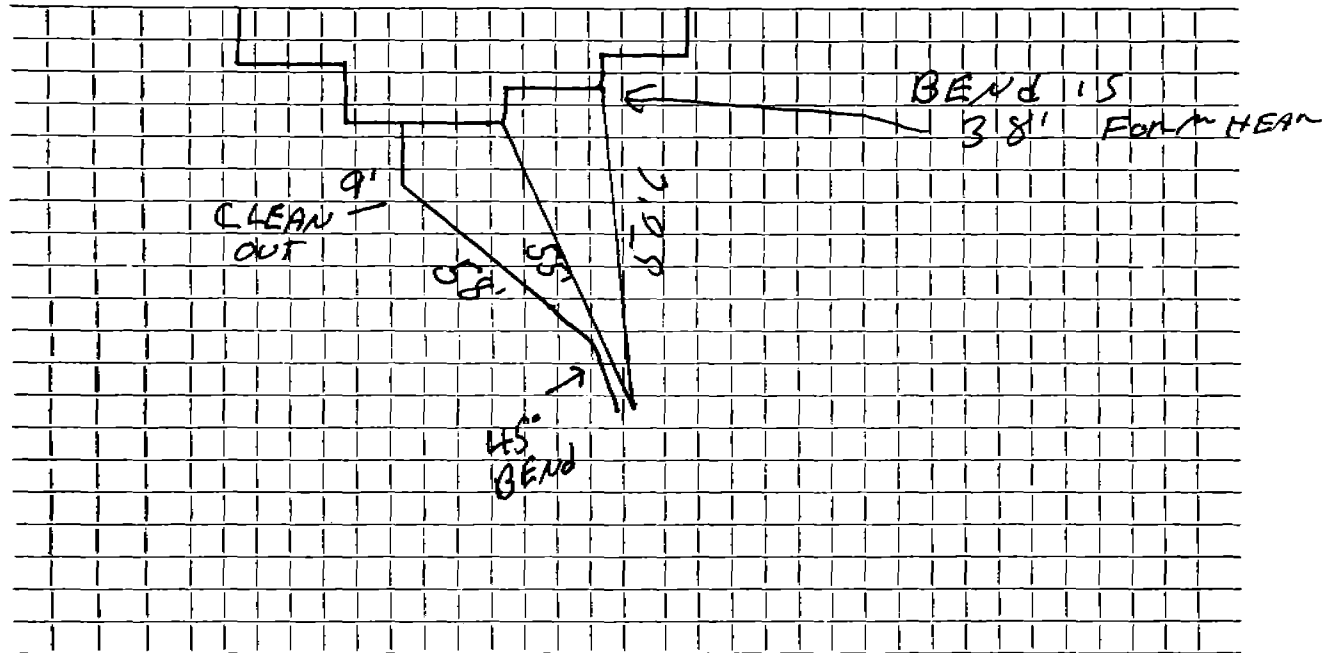

Connection made in ..... Street. Work completed .....

Remarks: .....  
.....  
.....