




DATE 8/7/80

TOWN OF LEXINGTON — BOARD OF PUBLIC WORKS  
SEWER DIVISION

Sketch of Service Here

26

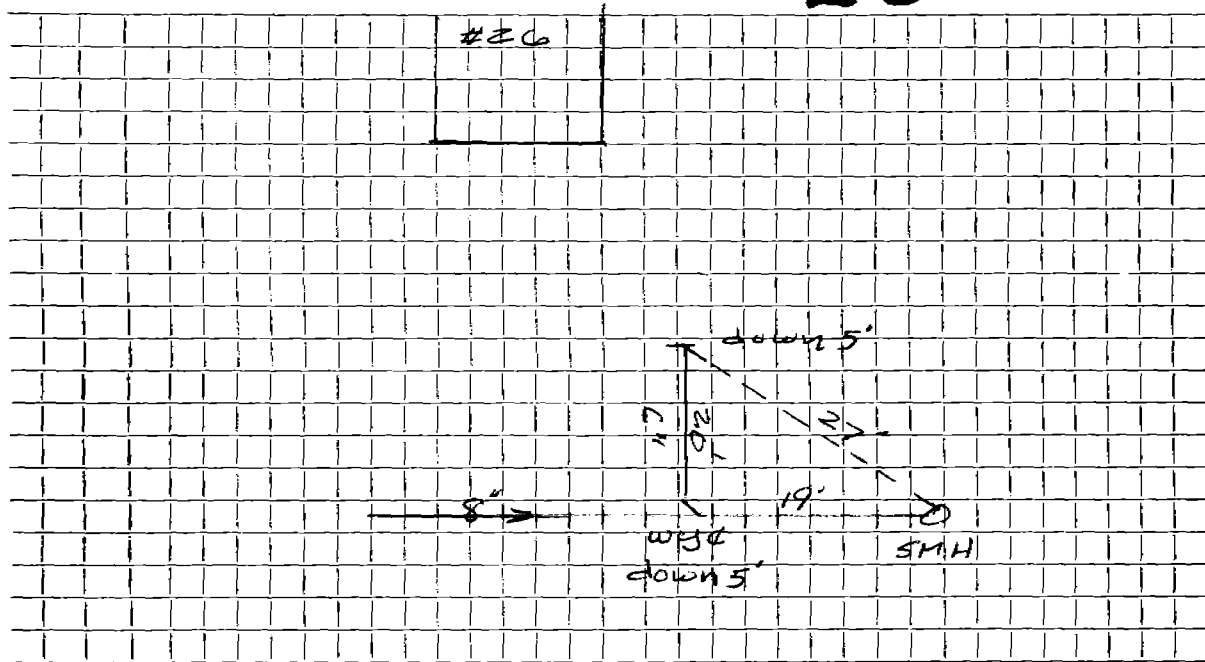

Connection made in BIRD HILL RD. Street. Work completed .....

Remarks: .....  
.....  
.....