

Name Forbes

Service No. 53 S

Address A BIRD HILL RD.

Location

Kind of Pipe PVC

Size 4" x 6"

Size of Main 8"

Repair—Renewal—New Service

Griecci Bros #4968


Location

Date	Material	Amount	Total	Date	Amount
4/11/88	10 LF 4" PVC			3-31-88	152 00
	80.5 LF 6" PVC				
	2-22° 6" ELBOWS			5-2-79	
	4" x 6" FERRO			8' 6" A.C. Pipe	
	4" x 6" WYE w/ CLEANOUT				
5-2-79	8' 6" A.C. Pipe @ 19.00		152 00		

DATE 4/11/88

TOWN OF LEXINGTON — BOARD OF PUBLIC WORKS
SEWER DIVISION

Sketch of Service Here **4**

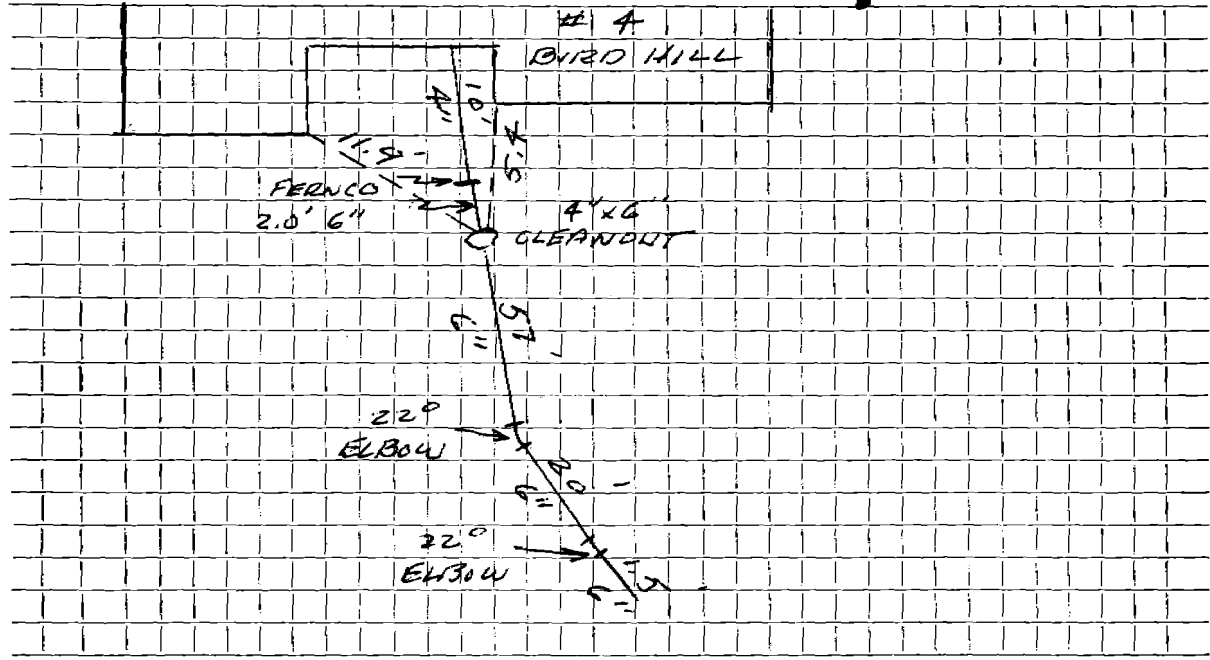

Connection made in BIRD HILL RD. Street. Work completed

Remarks: