


DATE 8/5/80

TOWN OF LEXINGTON — BOARD OF PUBLIC WORKS
SEWER DIVISION

Sketch of Service Here

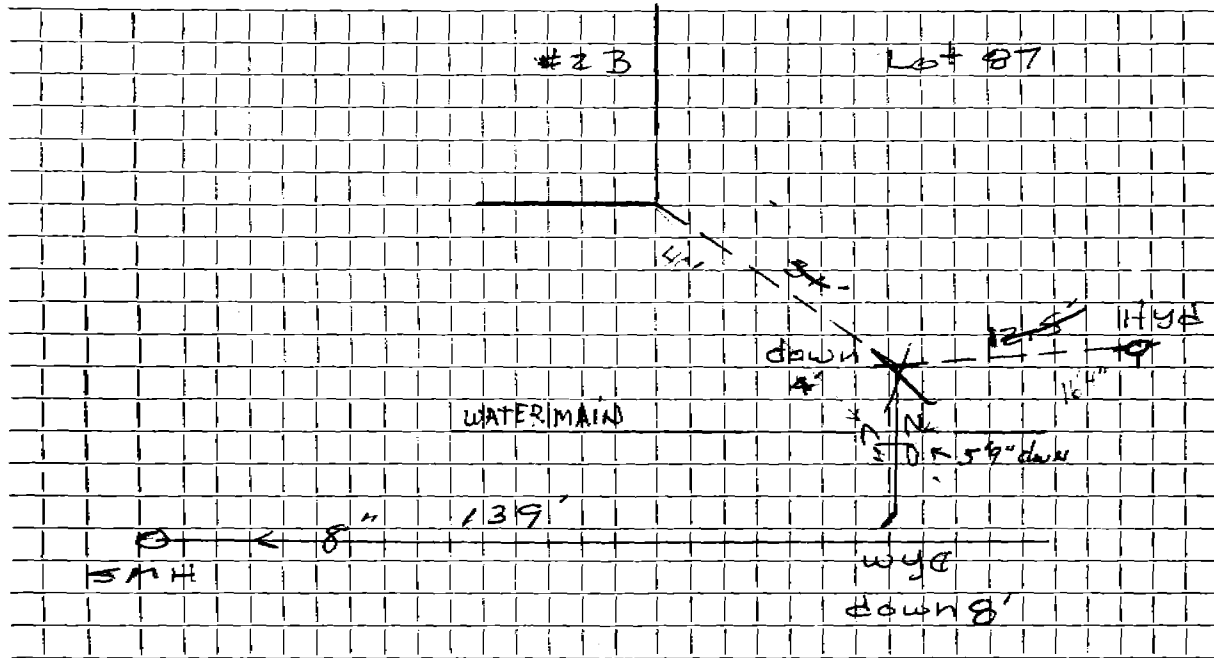

Connection made in BIRD HILL RD. Street. Work completed

Remarks: Pipe CEMENTED UP UNDER WATER MAIN - 5' 9" TO TOP OF AC. PIPE WATER MAIN 5' deep