


DATE 10/6/21

TOWN OF LEXINGTON — BOARD OF PUBLIC WORKS
SEWER DIVISION

Sketch of Service Here

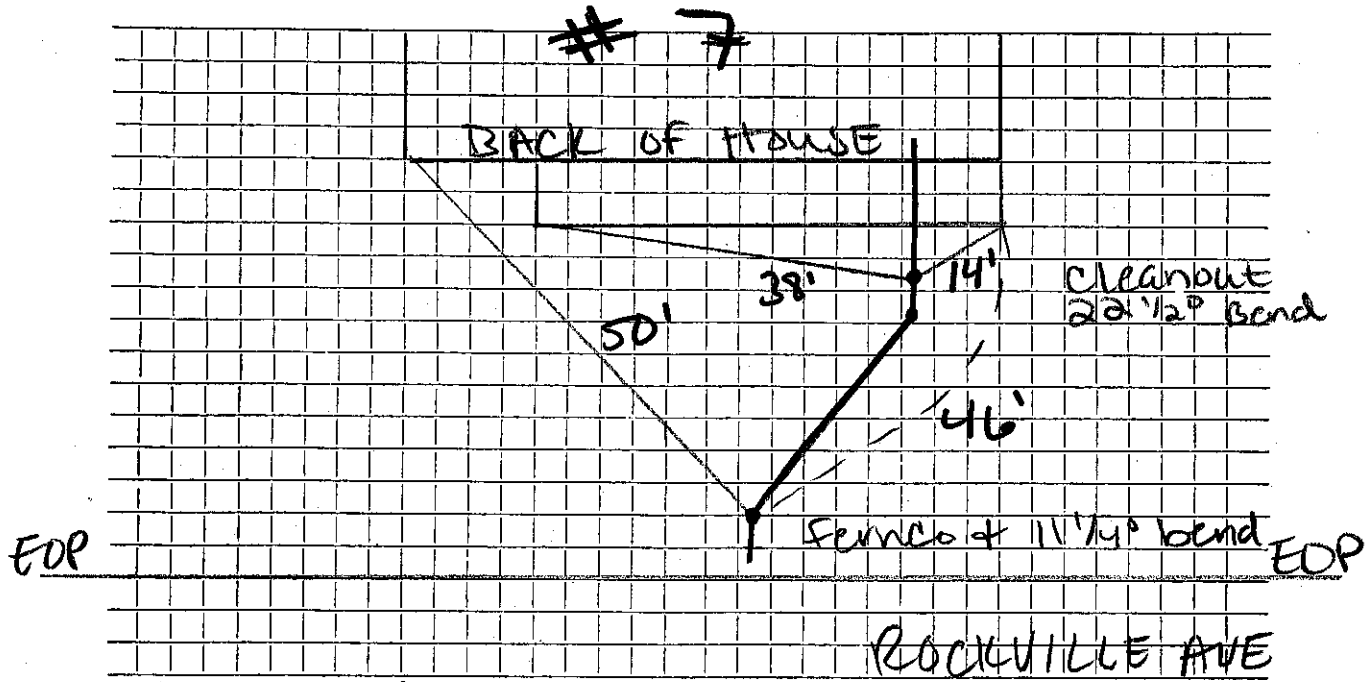

Connection made in Rockville Ave Street. Work completed

Remarks: 7 Bird Hill Rd