

Name James J. Leahy

Service No. 124

Address 106 Blake Road

Location

Kind of Pipe

Size

Size of Main

Repair—Renewal—New Service Lexington Sewerage #2350

Location NOV 19 1973

Date	Material	Amount	Total	Date	Amount
	37' 6" V.C.Pipe @ 3.00		111 00	9-25-73	111 00
	Installed by contractor Bill owner when connected				
10-1-73	26' 6" Transite pipe				
	32' 6" V.C.				
	Labor				

TOWN OF LEXINGTON—DEPT. OF PUBLIC WORKS  
**SEWER DIVISION**

DATE.....

NO. ....

The undersigned applies for the construction of a particular sewer connecting No.....  
Street and hereby agrees to comply with the Rules and Regulations governing the construction and use of Particular  
Sewers, as now or at any future time established by the Board of Selectmen.


Am't of estimate \$.....

Am't Paid \$.....

..... Owner

Sketch of Service Here

**106**

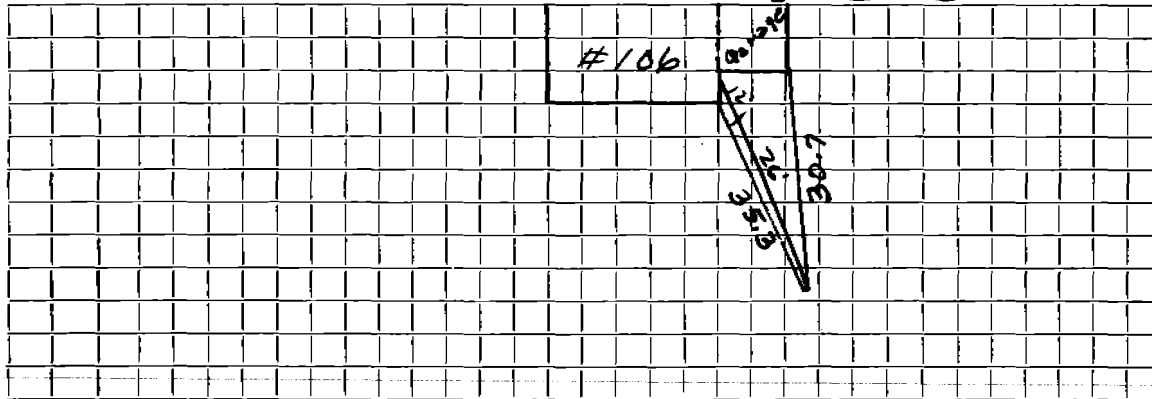

Connection made in ..... Street.

Work completed.....19..

Remarks: