

Name Moore Realty Trust

Service No. 14

Address #11 Blake Rd.

Lot #

Location

Kind of Pipe

Size

Size of Main

~~Repair~~ ~~Renewal~~ — **New Service** DeFlice Bros Permit #214

Location MAY 17 1965


Date	Material	Amount	Total	Date	Amount	
1964	34'	6" transite pipe install by contractor @ 7.00 per ft.	238 00	3-15-65	<i>Deposit</i>	238 00
4-9-65	74'	6" Transite pipe				

H.B.M.18501

**TOWN OF LEXINGTON — BOARD OF PUBLIC WORKS  
SEWER DIVISION**

Sketch of Service Here

**11**

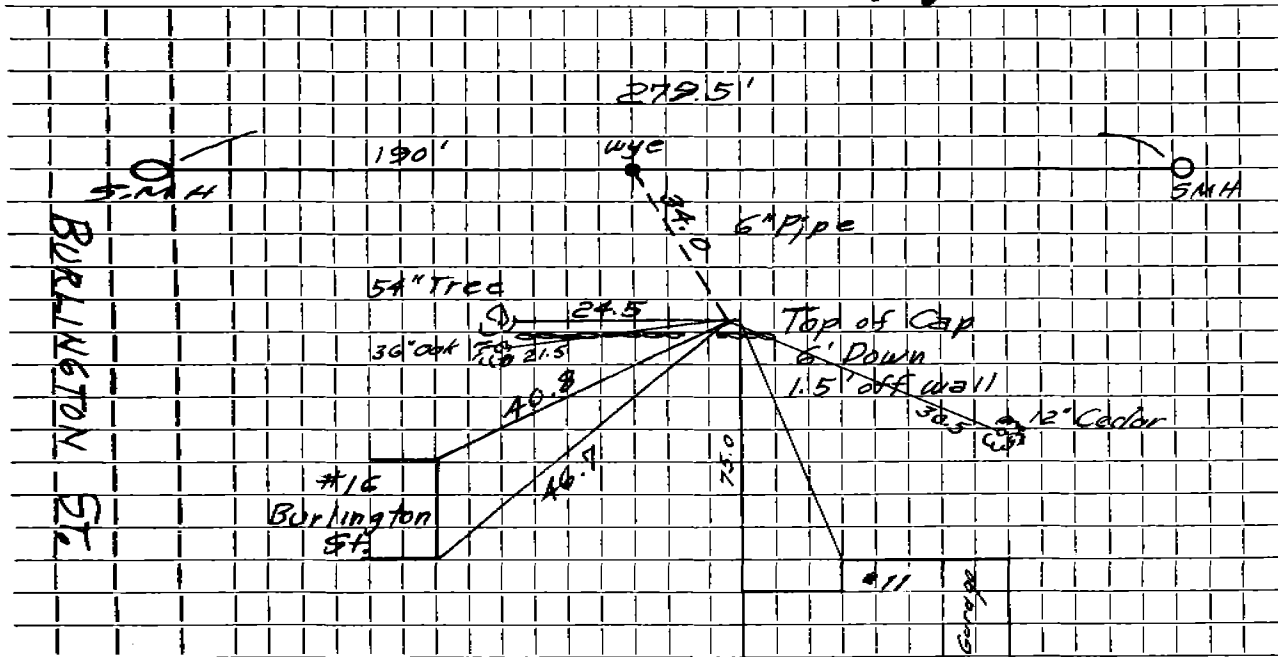

Connection made in ..... Street. Work completed .....

Remarks: .....

.....

.....