




DATE JAN 13, 1983

TOWN OF LEXINGTON — BOARD OF PUBLIC WORKS  
SEWER DIVISION

Sketch of Service Here

127

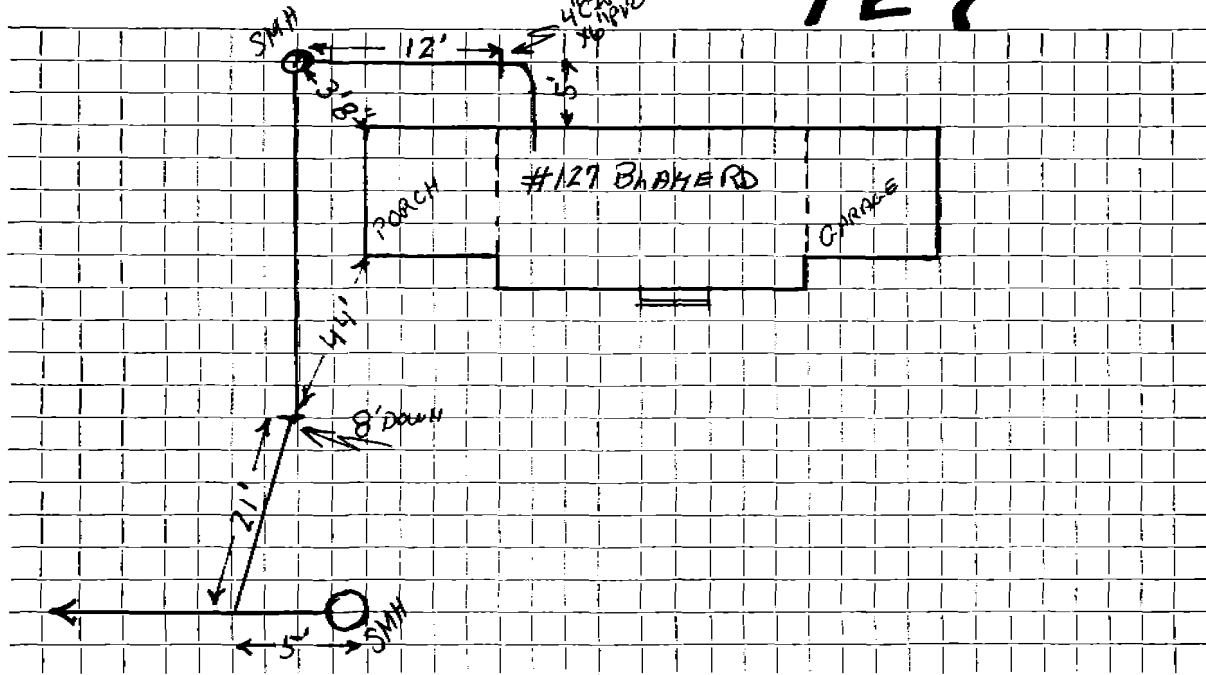

Connection made in BLATHERD Street.

Work completed July 12, 1984

Remarks: .....

.....

.....