

Name Alan C. Wagner

Service No. 222

Address #24 Blake Rd.

Location

Kind of Pipe Permit #A73

Size

Size of Main

~~Repair/Replacement~~ - New Service Lexington Sewerage Co.

Location DEC 31 1965


Date	Material	Amount	Total	Date	Amount
1964	26 1/2' 6" Transite pipe install by contractor @ 7.00 per ft.		185 50	11-5-65	Deposit 185.50
11-8-65	32' 6" Transite pipe				

DATE _____

TOWN OF LEXINGTON — BOARD OF PUBLIC WORKS

SEWER DIVISION

Sketch of Service Here **24**

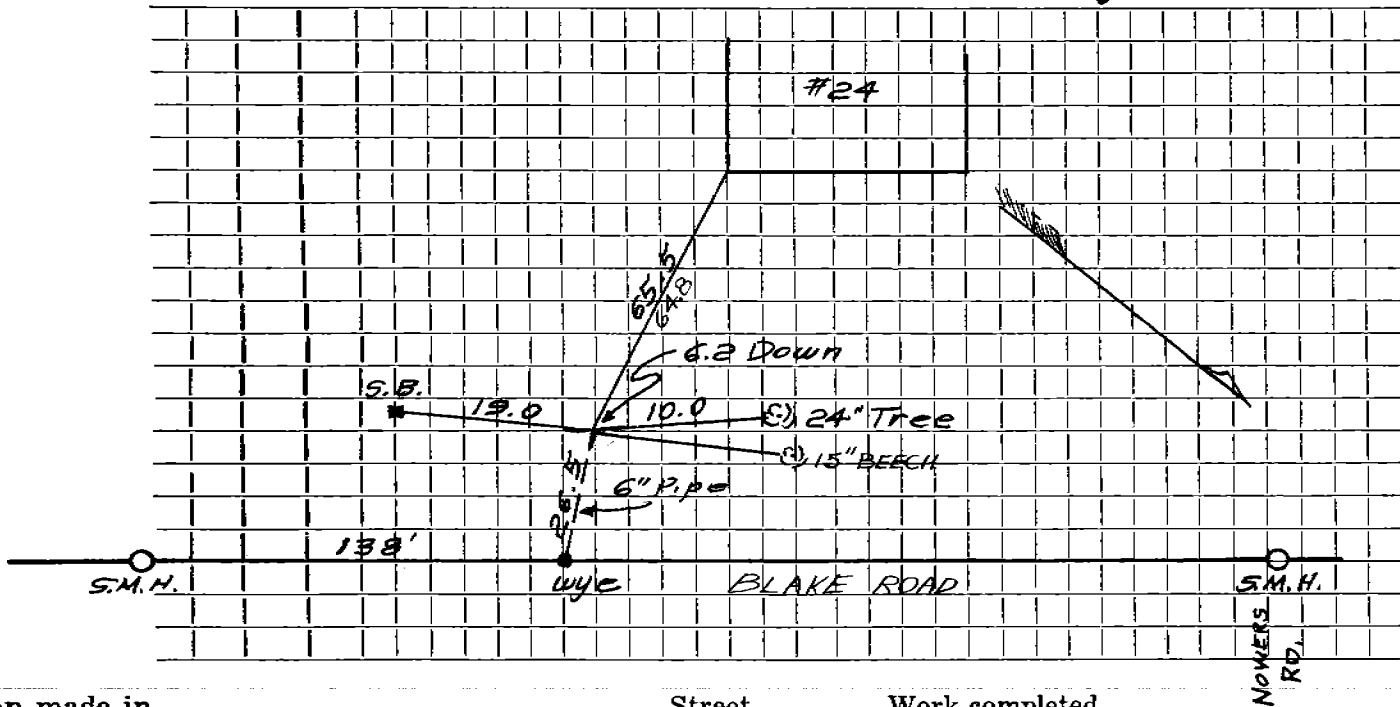

Connection made in Street. Work completed

Remarks:
.....
.....