

Name

Service No.

Address #30 Blake Rd.

Location

Kind of Pipe

Size

Size of Main

Repair—Renewal—New Service


Location

Date		Material	Amount	Total		Date		Amount	
1964	22'	6" Transite pipe install by contractor @ 7.00 per ft.		154	00				

DATE _____

TOWN OF LEXINGTON — BOARD OF PUBLIC WORKS
SEWER DIVISION

Sketch of Service Here **30**

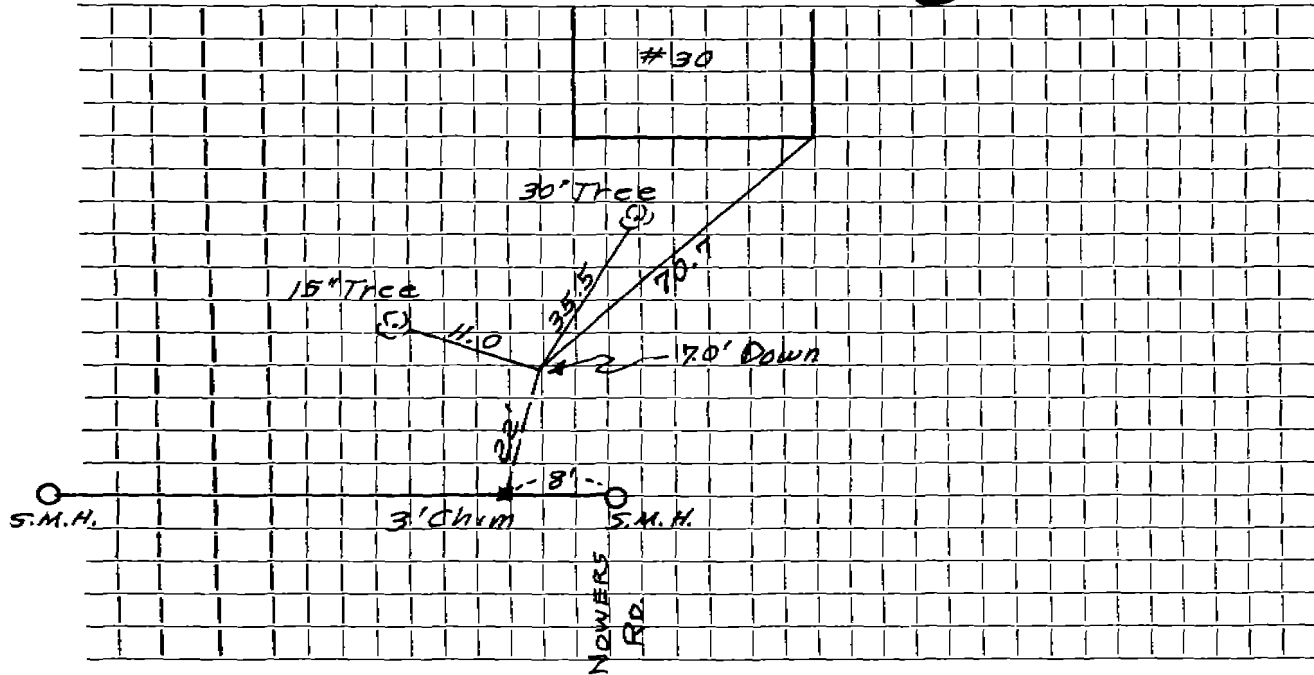

Connection made in Street. Work completed

Remarks:


.....

.....

DATE DEC 10 1997

TOWN OF LEXINGTON — BOARD OF PUBLIC WORKS
SEWER DIVISION

Sketch of Service Here

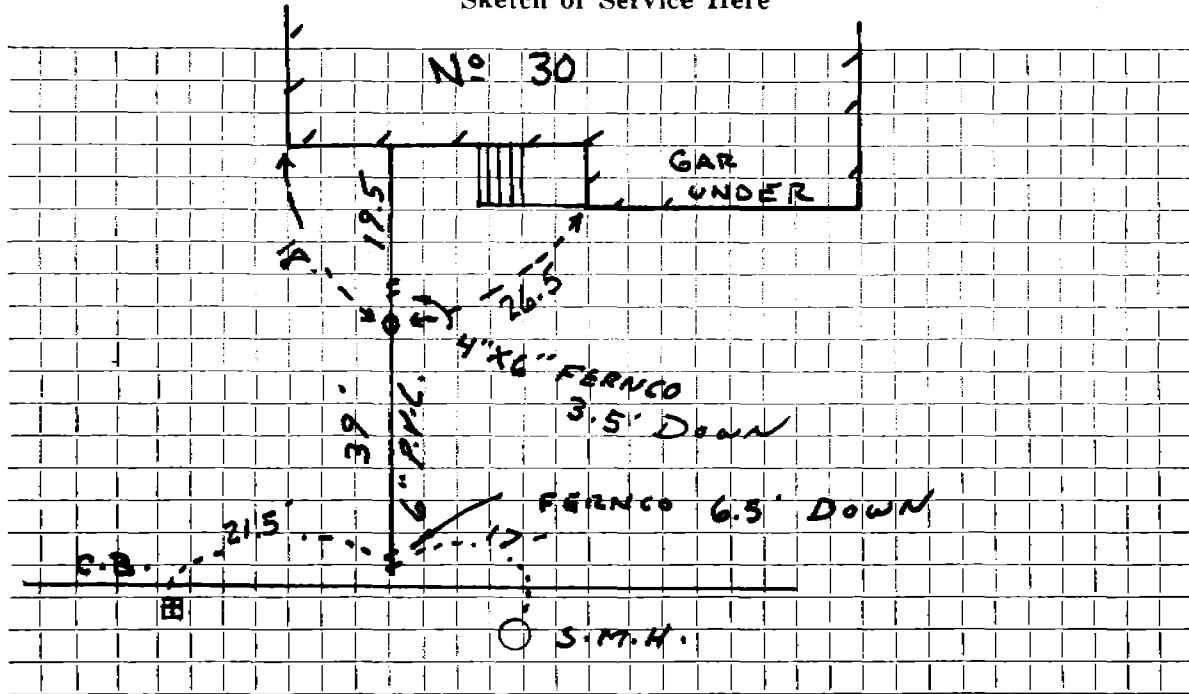

Connection made in BLAKE Street. Work completed ARLEX OIL

Remarks:

.....

FIELD BOOK 97-5 TIM