



TOWN OF LEXINGTON
OFFICE OF SELECTMEN

5-8-07

Date

To *Douglas Morgan / Cynthia Sicker*

Under Article 6 section 2 of the General By-Laws of the Town of Lexington, it is ordered that "The Selectmen shall determine and designate numbers for the buildings abutting upon or adjacent to such streets or portions of streets as they may deem best for public convenience. No person shall neglect or refuse to affix to any building owned by him, the street number designated for him by said board."

The owner of the building on

33 BLAKE RD
Street

71/279
Lot No.

is hereby notified that
the proper number is

2 NOWERS RD.

BOARD OF SELECTMEN

By *Peter Karalakis*

Name Larry Trebino

Service No. 174

Address #33 Blake Rd.

JUN 18 1973

Location

Kind of Pipe

Size

6"

Size of Main

~~Repair~~ ~~Renewal~~ — New Service

Trebino Const. #2182

Location

Date

Material

Amount

Total

Date

Amount

1964 27

6" Transite pipe install by contractor @ 7.00 per ft.

189 00

11-20-72

Deposit


189 00

27

DATE _____

TOWN OF LEXINGTON — BOARD OF PUBLIC WORKS
SEWER DIVISION

Sketch of Service Here **33**

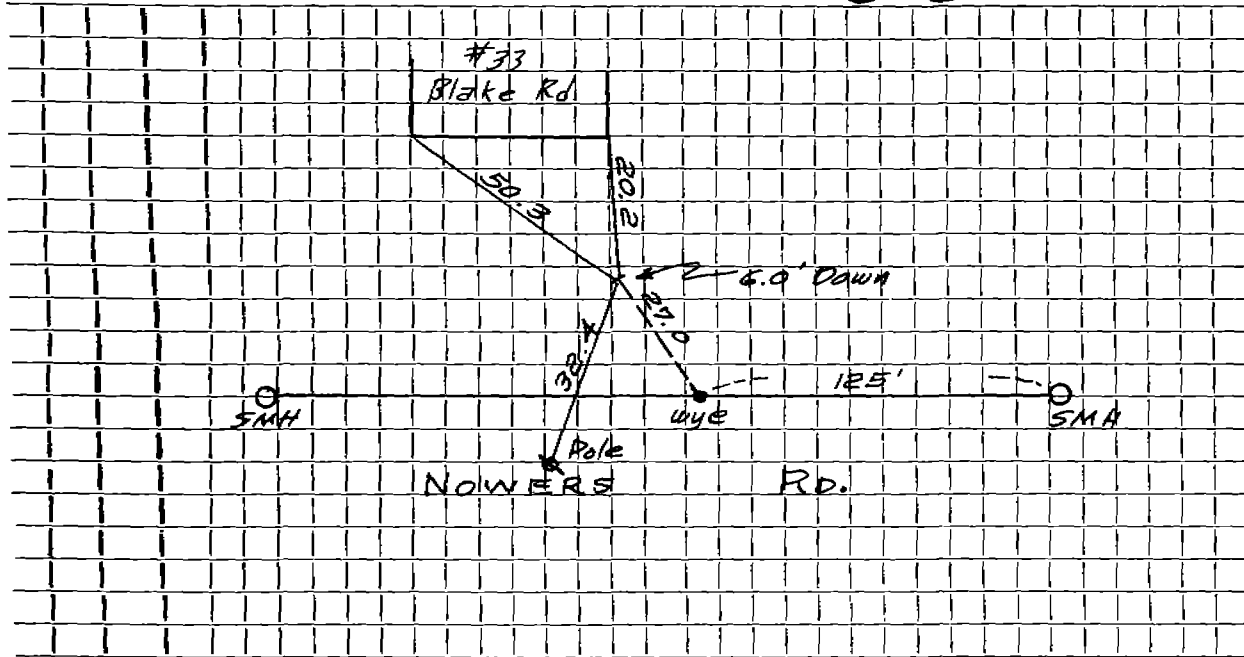

Connection made in Street. Work completed

Remarks:
.....
.....