

Name *Dr. Loran Bittman*

Service No. 10

Address # 39 Blake Road

Lot "K"

Location

Kind of Pipe

Size

Size of Main

Repair—Renewal—New Service *Valeri #1309*


Location **MAY 27 1969**

Date		Material	Amount	Total	Date		Amount
Oct. '67	24'	6" Transite pipe @7.00		168.00	<i>4-16-69</i>	<i>Deposit</i>	<i>168.00</i>
<i>4-17-69</i>	47'	6" Transite pipe					
	10'	4" Cast Iron pipe					

DATE \_\_\_\_\_

TOWN OF LEXINGTON — BOARD OF PUBLIC WORKS  
SEWER DIVISION

Sketch of Service Here **39**

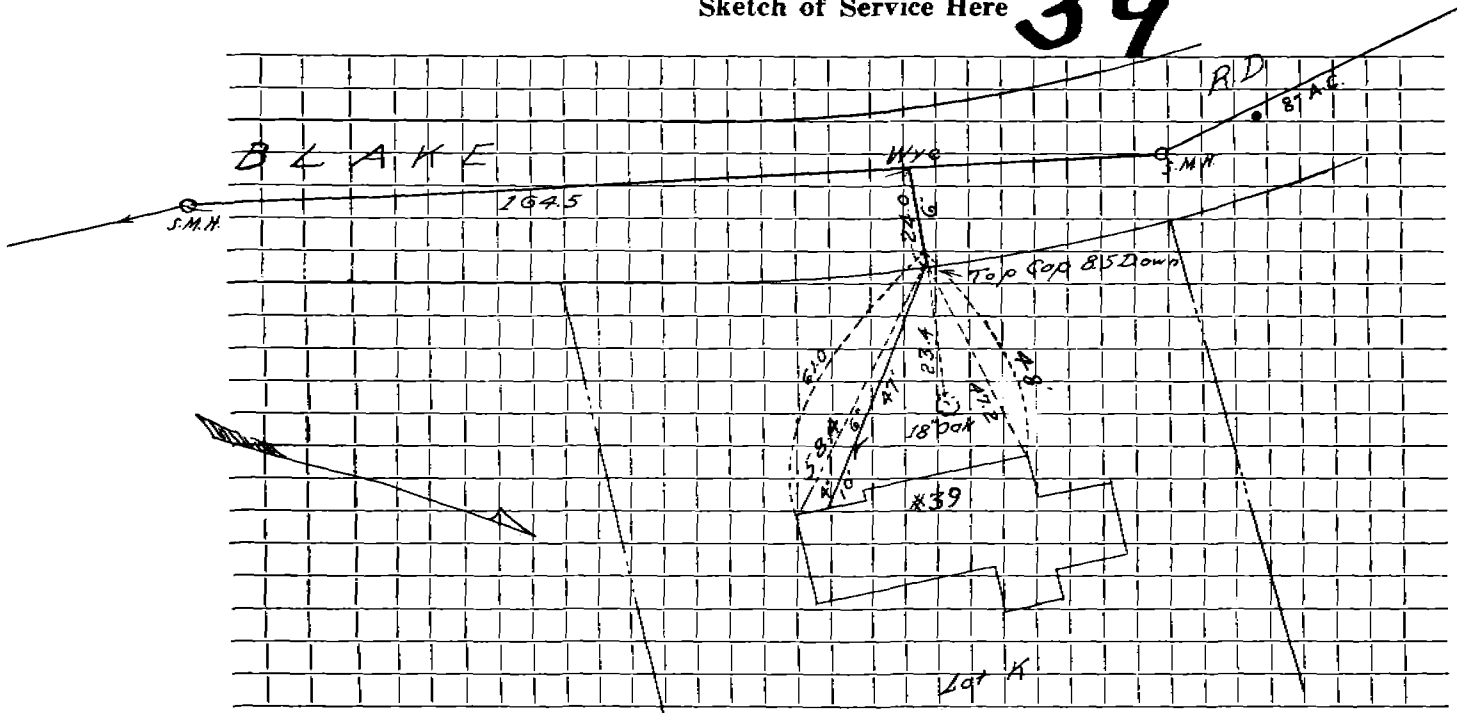

Connection made in ..... Street. Work completed .....

Remarks: .....  
.....  
.....