

Name Edward A. Phugis

Service No. 26

Address ~~44~~ Blake Road

Lots 34, 35, & 36

Location

Kind of Pipe

Size

Size of Main

Repair—Renewal—New Service Great Northern #3882

Location **NOV 19 1984**

Date	Material	Amount	Total	Date	Amount
------	----------	--------	-------	------	--------

Oct.'67	24'	6" Transite pipe @7.00							
			168.00	7-31-84	Deposit			168.00	
8/1/84	37'	6" PVC							
	2	45° Bends							
	1	AC to PVC Adpt							
	1	4" x 6" Donut							
	6'	4" PVC							


DATE \_\_\_\_\_

TOWN OF LEXINGTON — BOARD OF PUBLIC WORKS

SEWER DIVISION

Sketch of Service Here

40

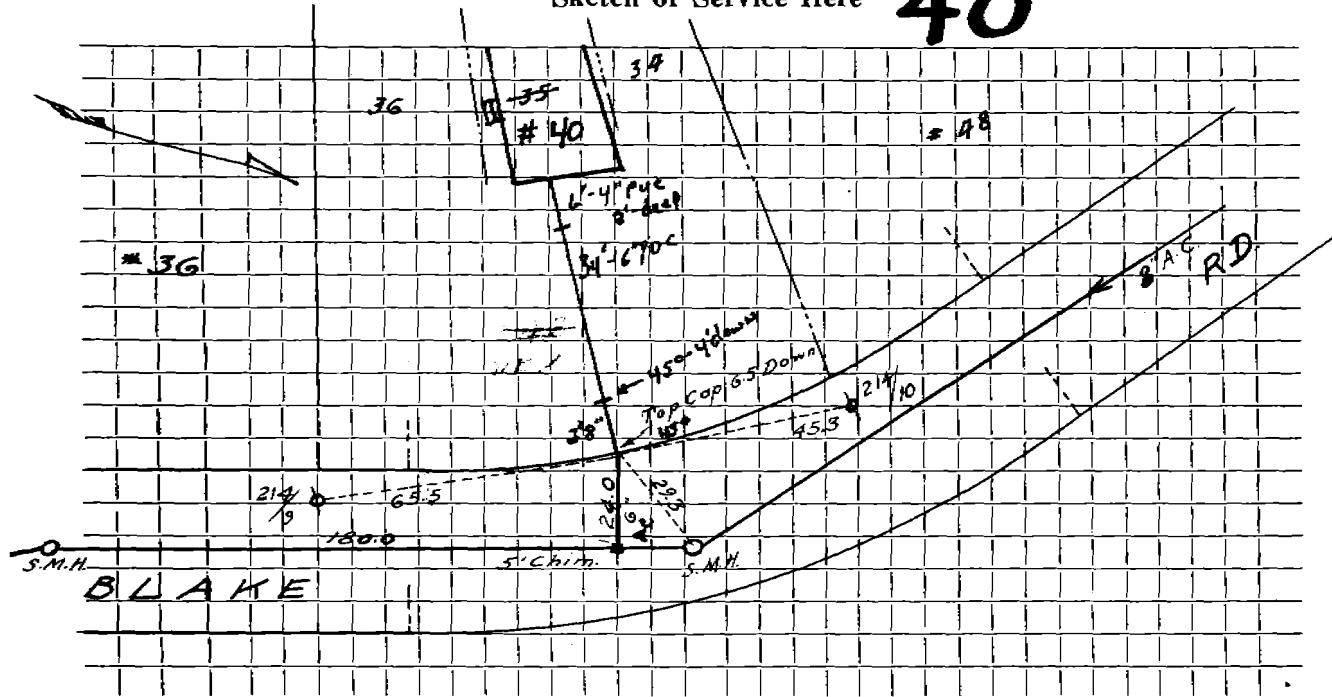

Connection made in ..... Street. Work completed .....

Remarks: .....

.....

.....